City of Prince George
HISTORY SHEET

008881898

SHEET NUMBER **Roll Number**

Legal: LOT'S B BLOCK D.L. 4046 PLAN 22547

Address: 5787 LEHMAN RD

Sanitary Connection: # 11708 SIZE 4" MATERIAL INV. 2297.06 CONNECTED

Water Connection # SIZE 3/4" MATERIAL Copper METER CONNECTED

Storm Connection: # SIZE MATERIAL INV. CONNECTED

Cash Receipt No's: WATER SANITARY 2527 STORM

CURB FROM PROPERTY LINE PAVEMENT WIDTH

B.C. HYDRO O.H. UNDERGROUND CONNECTION

B.C. TELEPHONE O.H. UNDERGROUND CONNECTION

INLAND GAS ?

Information Sheets:

Comments:
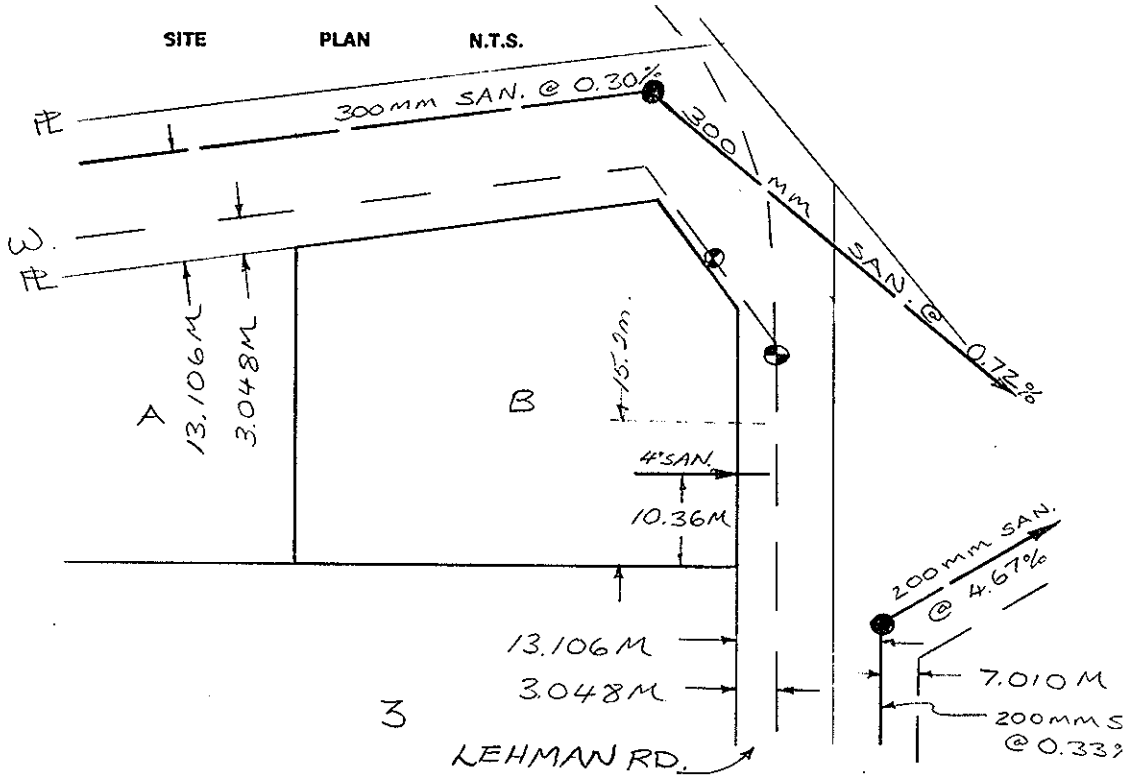
SITE PLAN N.T.S.