City of Prince George
HISTORY SHEET

SHEET NUMBER 10208 **Roll Number** 008889163

Legal: LOT'S 58 BLOCK D.L. 2433 PLAN 22464

Address: 7677 SAPPHIRE CRESCENT

Sanitary Connection: # SIZE 4" MATERIAL PVC INV. 24/10.6 CONNECTED

Water Connection # 5/ SIZE 3/4" MATERIAL Copper METER CONNECTED

Storm Connection: # SIZE MATERIAL INV. CONNECTED

Cash Receipt No's: WATER SANITARY STORM

CURB FROM PROPERTY LINE PAVEMENT WIDTH

B.C. HYDRO UNDERGROUND CONNECTION

B.C. TELEPHONE UNDERGROUND CONNECTION

INLAND GAS

Information Sheets:

Comments:
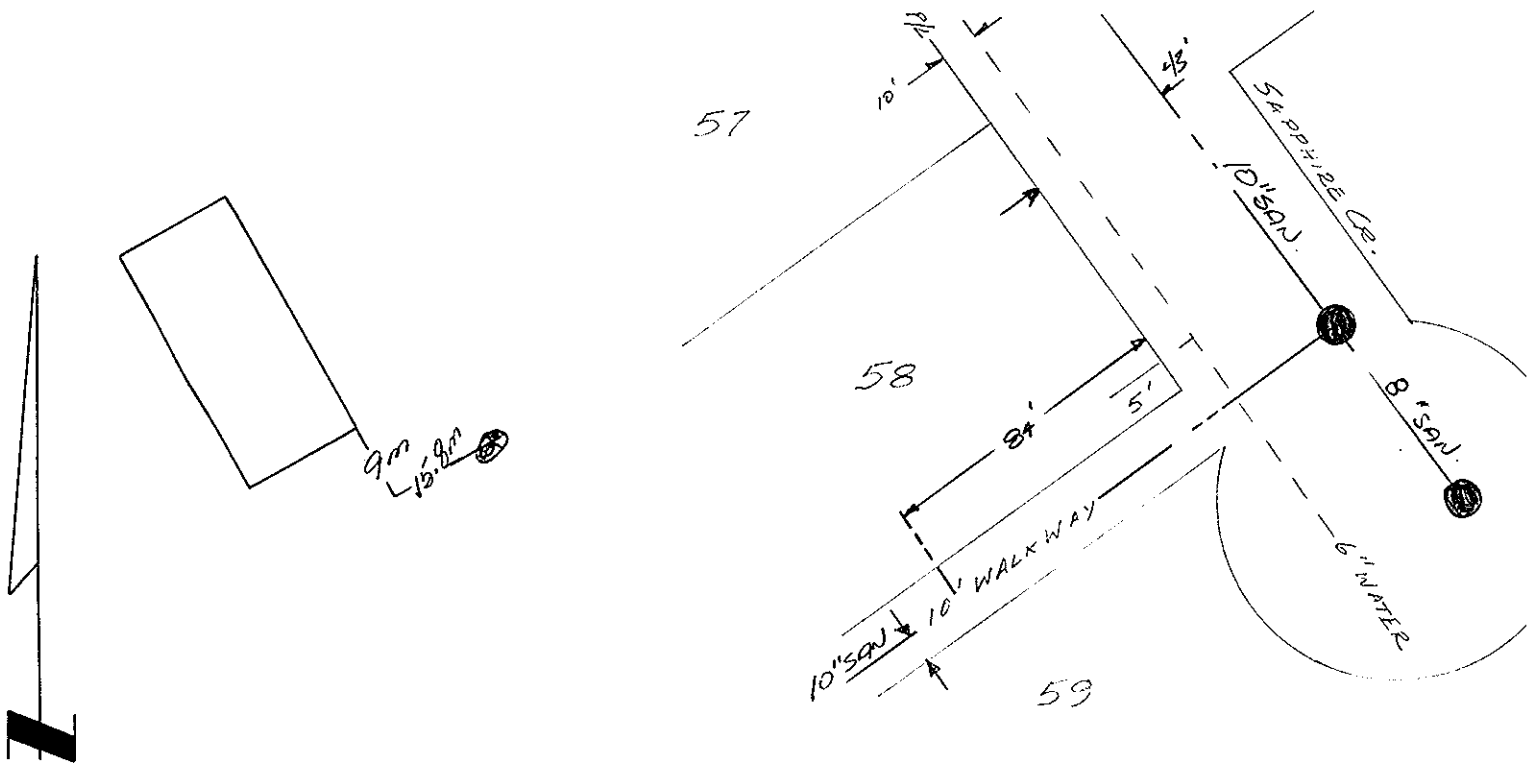
SITE PLAN N.T.S.