City of Prince George
HISTORY SHEET

SHEET NUMBER 10215 **Roll Number** 00888922

Legal: LOT'S 65 BLOCK D.L. 2433 PLAN 22464

Address: 7627 SAPPHIRE CRESCENT

Sanitary Connection: # SIZE 4" MATERIAL PVC. INV. 24/10.2 CONNECTED

Water Connection # SIZE 3/4" MATERIAL COPPER METER CONNECTED

Storm Connection: # SIZE MATERIAL INV. CONNECTED

Cash Receipt No's: WATER SANITARY STORM

CURB FROM PROPERTY LINE PAVEMENT WIDTH

B.C. HYDRO UNDERGROUND CONNECTION

B.C. TELEPHONE UNDERGROUND CONNECTION

INLAND GAS

Information Sheets:

Comments:
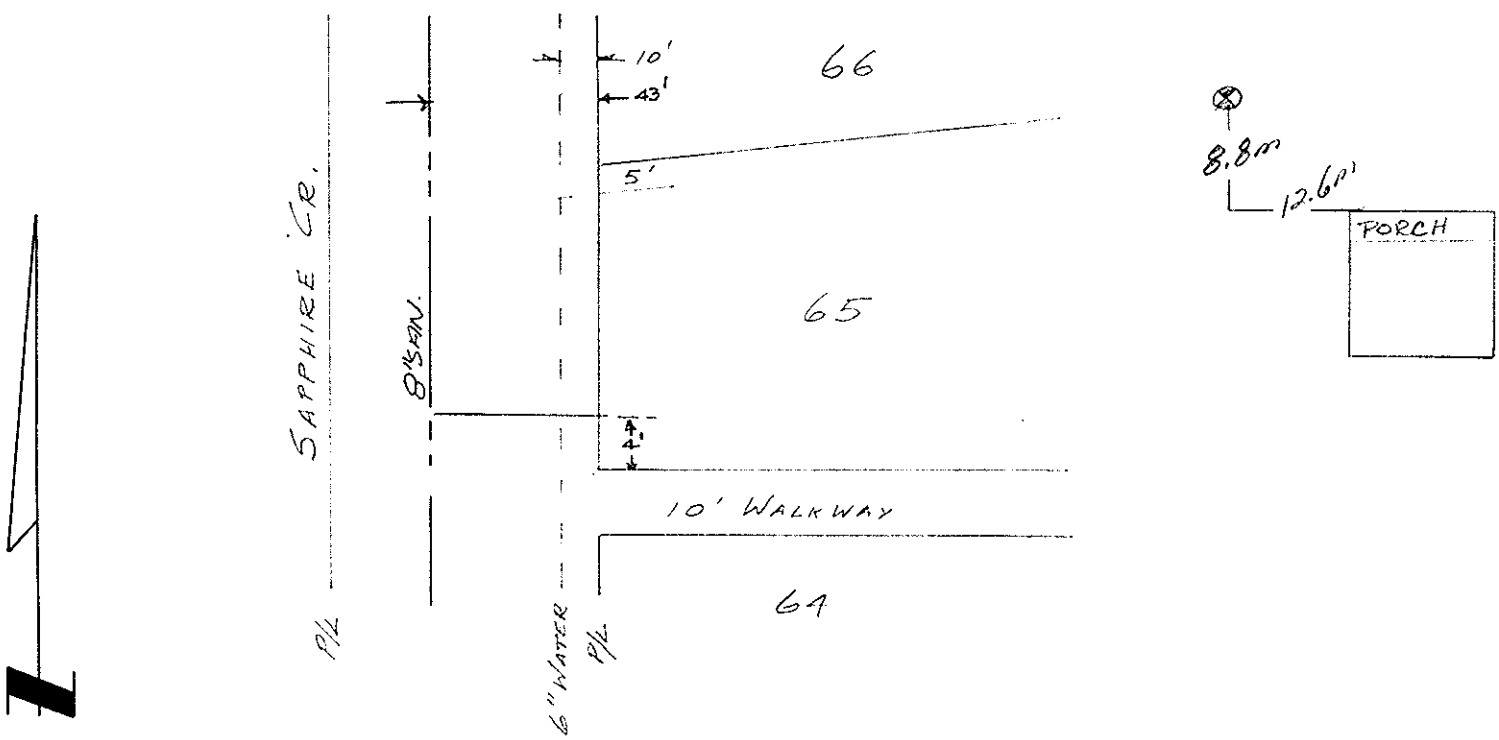
SITE PLAN N.T.S.