City of Prince George
HISTORY SHEET

SHEET NUMBER 8941 **Roll Number** 3089204 86

Legal: LOT'S 20 BLOCK D.L. S. E 1/4 D/L 754 PLAN 22373

Address: 7019 GUELPH CRES.

Sanitary Connection: # SIZE 4" MATERIAL A/C INV. 2006 CONNECTED

Water Connection # SIZE 3/4" MATERIAL COPPER METER CONNECTED

Storm Connection: # SIZE MATERIAL INV. CONNECTED

Cash Receipt No's: WATER SANITARY STORM

CURB FROM PROPERTY LINE 16 FT PAVEMENT WIDTH 34 FT

B.C. HYDRO 3 FT UNDERGROUND CONNECTION

B.C. TELEPHONE 3 FT UNDERGROUND CONNECTION

INLAND GAS 10 FT

Information Sheets:

Comments:
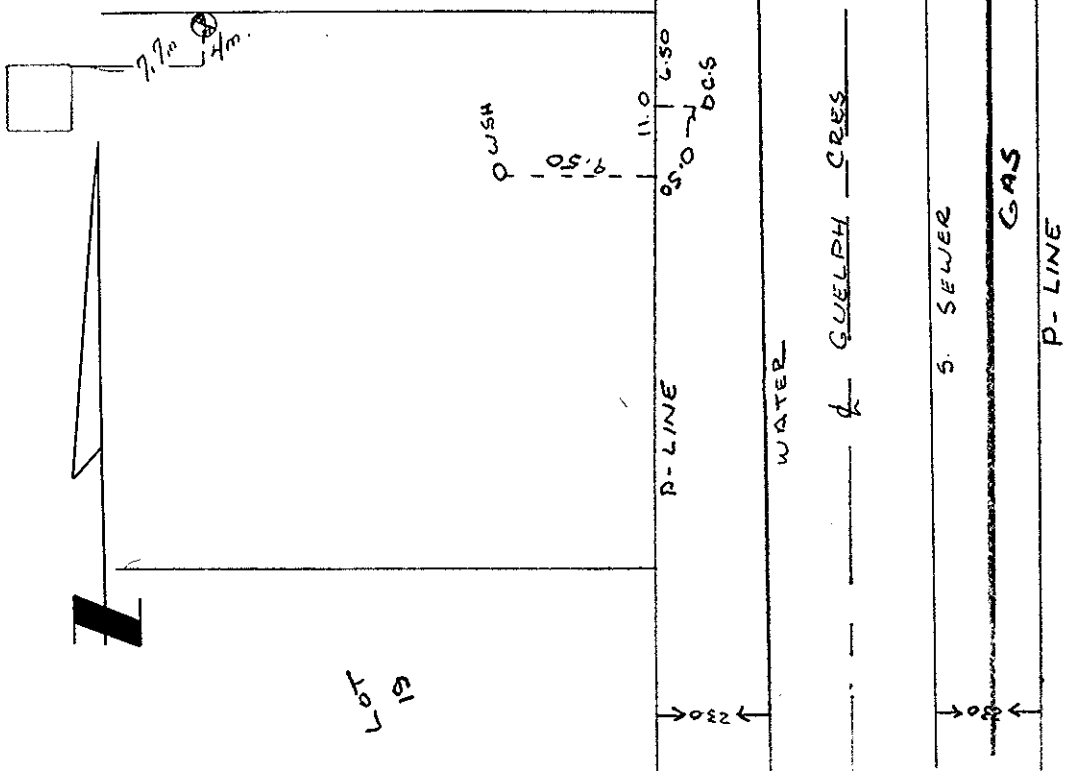
SITE PLAN N.T.S.