City of Prince George
HISTORY SHEET

SHEET NUMBER 4069 **Roll Number** 008950440

Legal: LOT'S 70 BLOCK D.L. 2608 PLAN 22362

Address: 140 CLAXTON CRES.

Sanitary Connection: # 9969 SIZE 4" MATERIAL A.C INV. 76.59 CONNECTED YES

Water Connection # 9969 SIZE 3/4" MATERIAL Co. METER No CONNECTED YES

Storm Connection: # SIZE MATERIAL INV. CONNECTED

Cash Receipt No's: WATER SANITARY STORM

CURB FROM PROPERTY LINE 16' PAVEMENT WIDTH 34'

B.C. HYDRO UNDERGROUND CONNECTION

B.C. TELEPHONE UNDERGROUND CONNECTION

INLAND GAS

Information Sheets:

Comments:

CONN'S CENTRED ON LOT
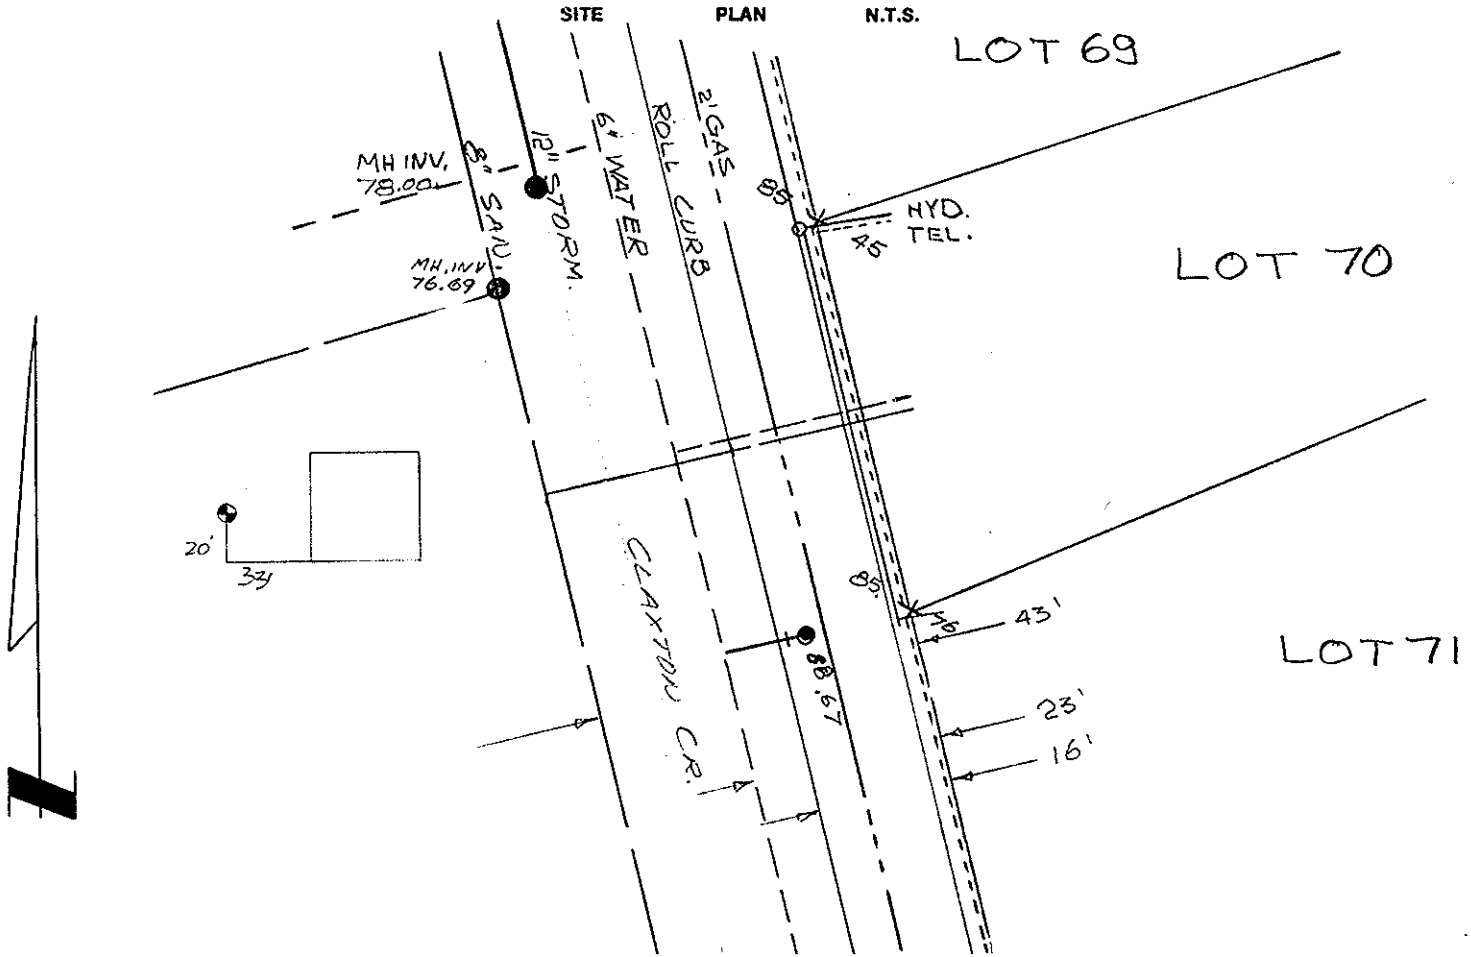
SITE PLAN N.T.S.