City of Prince George
HISTORY SHEET

SHEET NUMBER **Roll Number** 008952540

Legal: LOT'S 184 BLOCK D.L. 2608 PLAN 22 362

Address: 4383 FLYNN AVE.

Sanitary Connection: # 10 262 SIZE 100mm MATERIAL A.C. INV. 604.683 CONNECTED YES

Water Connection # 10 262 SIZE 20mm MATERIAL PLASTIC METER NO CONNECTED YES

Storm Connection: # SIZE MATERIAL INV. CONNECTED

Cash Receipt No's: WATER SANITARY STORM

CURB FROM PROPERTY LINE 4.877 m PAVEMENT WIDTH 10.363 m

B.C. HYDRO AS SHOWN UNDERGROUND CONNECTION

B.C. TELEPHONE AS SHOWN UNDERGROUND CONNECTION

INLAND GAS AS SHOWN

Information Sheets:

Comments:
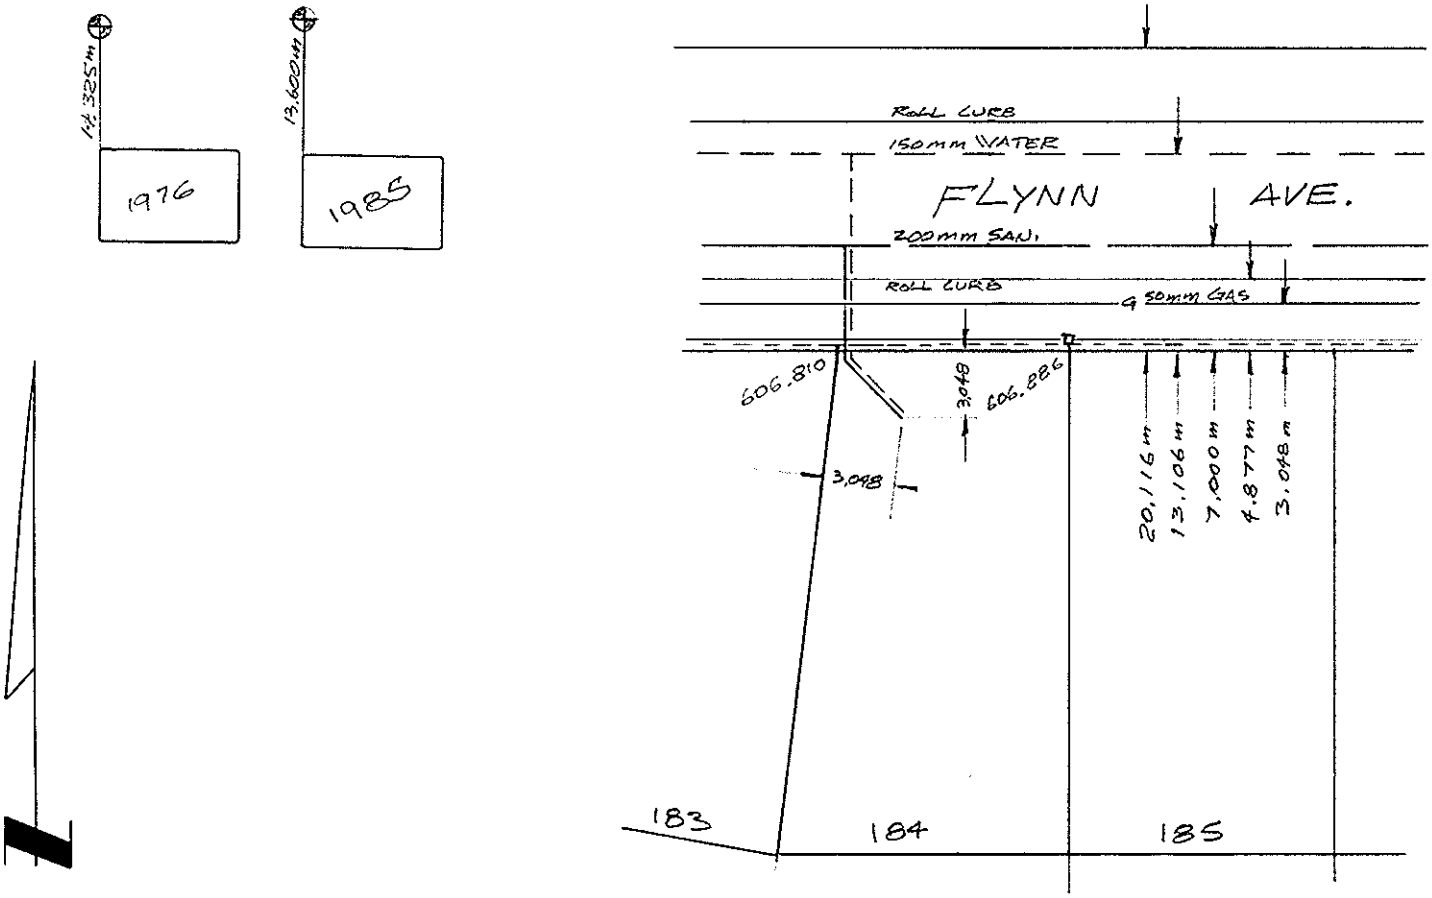
THE INFORMATION CONTAINED HEREIN IS FOR INTERNAL USE ONLY.
NOT TO BE RELIED UPON UNLESS CONFIRMED BY SITE INSPECTION AND/OR INVESTIGATION