# City of Prince George
## HISTORY SHEET

SHEET NUMBER **Roll Number** 00895.255Y

**Legal:** LOT'S 185 BLOCK D.L. 2608 PLAN 22362

**Address:** 4375 FLYNN AVE.

**Sanitary Connection:** # 10263 SIZE 100 mm MATERIAL A.C. INV. 604.649 CONNECTED YES

**Water Connection** # 10263 SIZE 20mm MATERIAL PLASTIC METER NO CONNECTED YES

**Storm Connection:** # SIZE MATERIAL INV. CONNECTED

**Cash Receipt No's:** WATER SANITARY STORM

CURB FROM PROPERTY LINE 4.877 m PAVEMENT WIDTH 10.363 m

B.C. HYDRO AS SHOWN UNDERGROUND CONNECTION

B.C. TELEPHONE AS SHOWN UNDERGROUND CONNECTION

INLAND GAS AS SHOWN

**Information Sheets:**

**Comments:**
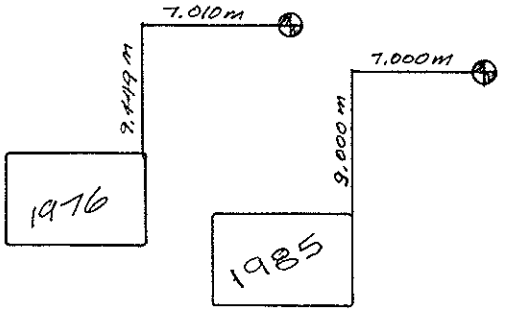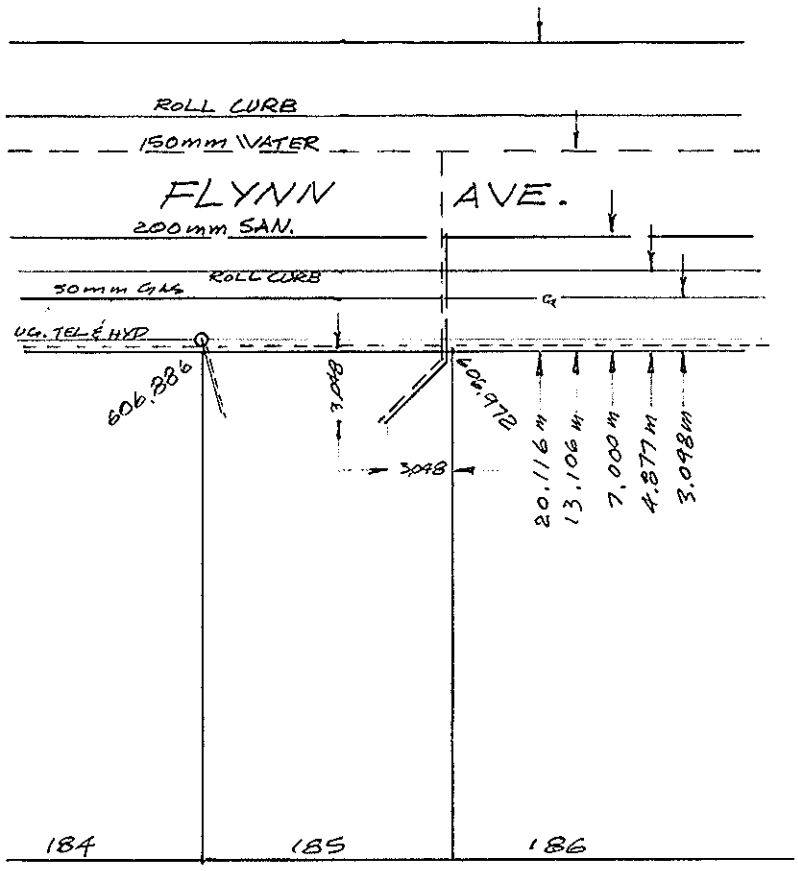
**THE INFORMATION CONTAINED HEREIN IS FOR INTERNAL USE ONLY.**
**NOT TO BE RELIED UPON UNLESS CONFIRMED BY SITE INSPECTION AND/OR INVESTIGATION**