City of Prince George
HISTORY SHEET

SHEET NUMBER **Roll Number** 00896944

Legal: LOT'S I BLOCK D.L. 2610 PLAN 22244

Address: 4222 QUENTIN AVE.

Sanitary Connection: # 8389 SIZE 100mm MATERIAL A.C. INV. CONNECTED

Water Connection # 8389 SIZE 20mm MATERIAL Cu. METER CONNECTED

Storm Connection: # SIZE MATERIAL INV. CONNECTED

Cash Receipt No's: WATER SANITARY STORM

CURB FROM PROPERTY LINE 4.877 m PAVEMENT WIDTH 10.363 m

B.C. HYDRO U/G UNDERGROUND CONNECTION

B.C. TELEPHONE U/G UNDERGROUND CONNECTION

INLAND GAS AS SHOWN

Information Sheets:

Comments:

THE INFORMATION CONTAINED HEREIN IS FOR INTERNAL USE ONLY.
NOT TO BE RELIED UPON UNLESS CONFIRMED BY SITE INSPECTION AND/OR INVESTIGATION

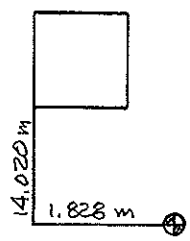
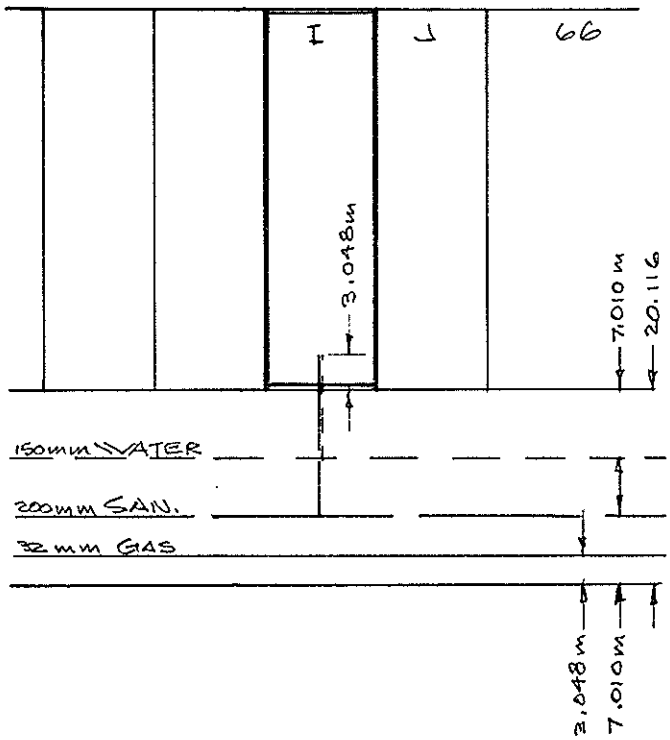
QUENTIN AVE.