City of Prince George
HISTORY SHEET

SHEET NUMBER № 0571 **Roll Number** 008 928 301

Legal: LOT'S 14 BLOCK D.L. 2507 PLAN 21450.

Address: 4283 FACTOR AVE.

Sanitary Connection: # 9013 SIZE 100mm MATERIAL A.C. INV. CONNECTED

Water Connection # SIZE 20mm MATERIAL Cu METER CONNECTED

Storm Connection: # SIZE MATERIAL INV. CONNECTED

Cash Receipt No's: WATER SANITARY STORM

CURB FROM PROPERTY LINE 4.877m PAVEMENT WIDTH 10.363m

B.C. HYDRO UNDERGROUND UNDERGROUND CONNECTION YES

B.C. TELEPHONE UNDERGROUND UNDERGROUND CONNECTION YES

INLAND GAS AS SHOWN

Information Sheets:

Comments:

4m
9.7m
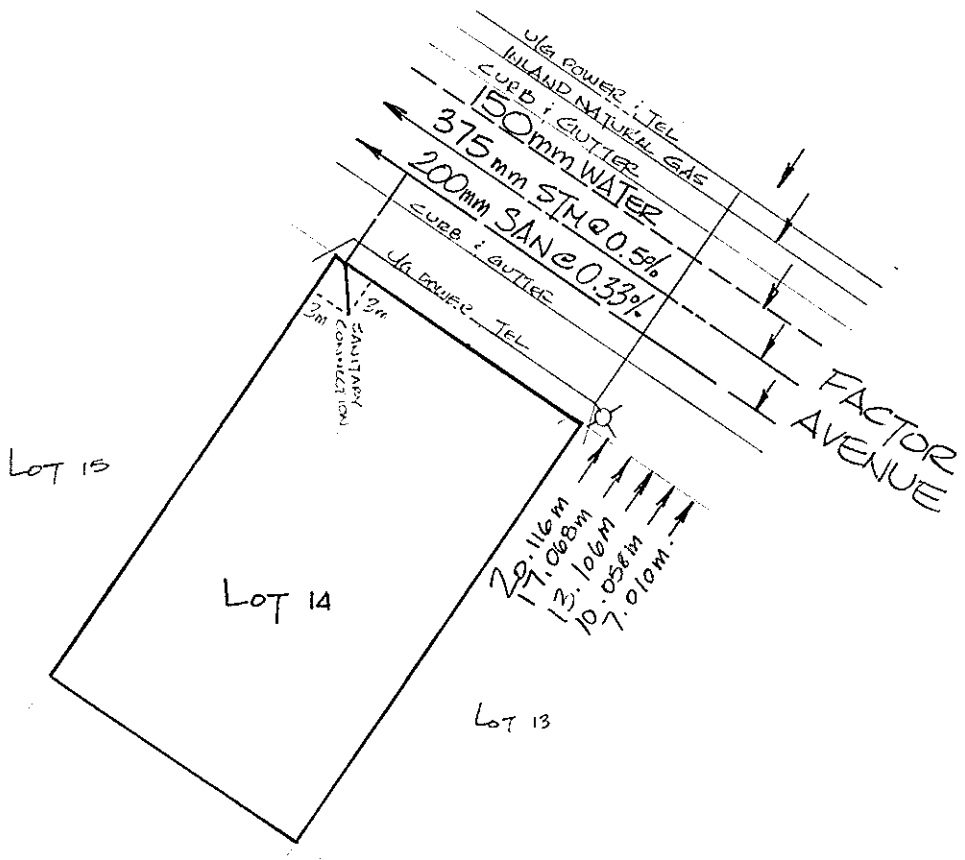
SITE PLAN N.T.S.