City of Prince George
HISTORY SHEET

SHEET NUMBER 7992 **Roll Number** 009 005 415.5

Legal: LOT'S 27 BLOCK D.L. 754 PLAN ~~22200~~ 22200

Address: 7719 MONCTON CRESENT

Sanitary Connection: # SIZE 4" MATERIAL AC INV. 2012 CONNECTED

Water Connection # SIZE 3/4" MATERIAL COPPER METER NONE CONNECTED

Storm Connection: # SIZE MATERIAL INV. CONNECTED

Cash Receipt No's: WATER SANITARY STORM

CURB FROM PROPERTY LINE 18' PAVEMENT WIDTH 30'

B.C. HYDRO 3' UNDERGROUND CONNECTION ✓

B.C. TELEPHONE 3' UNDERGROUND CONNECTION ✓

INLAND GAS 11.5'

Information Sheets:

Comments:
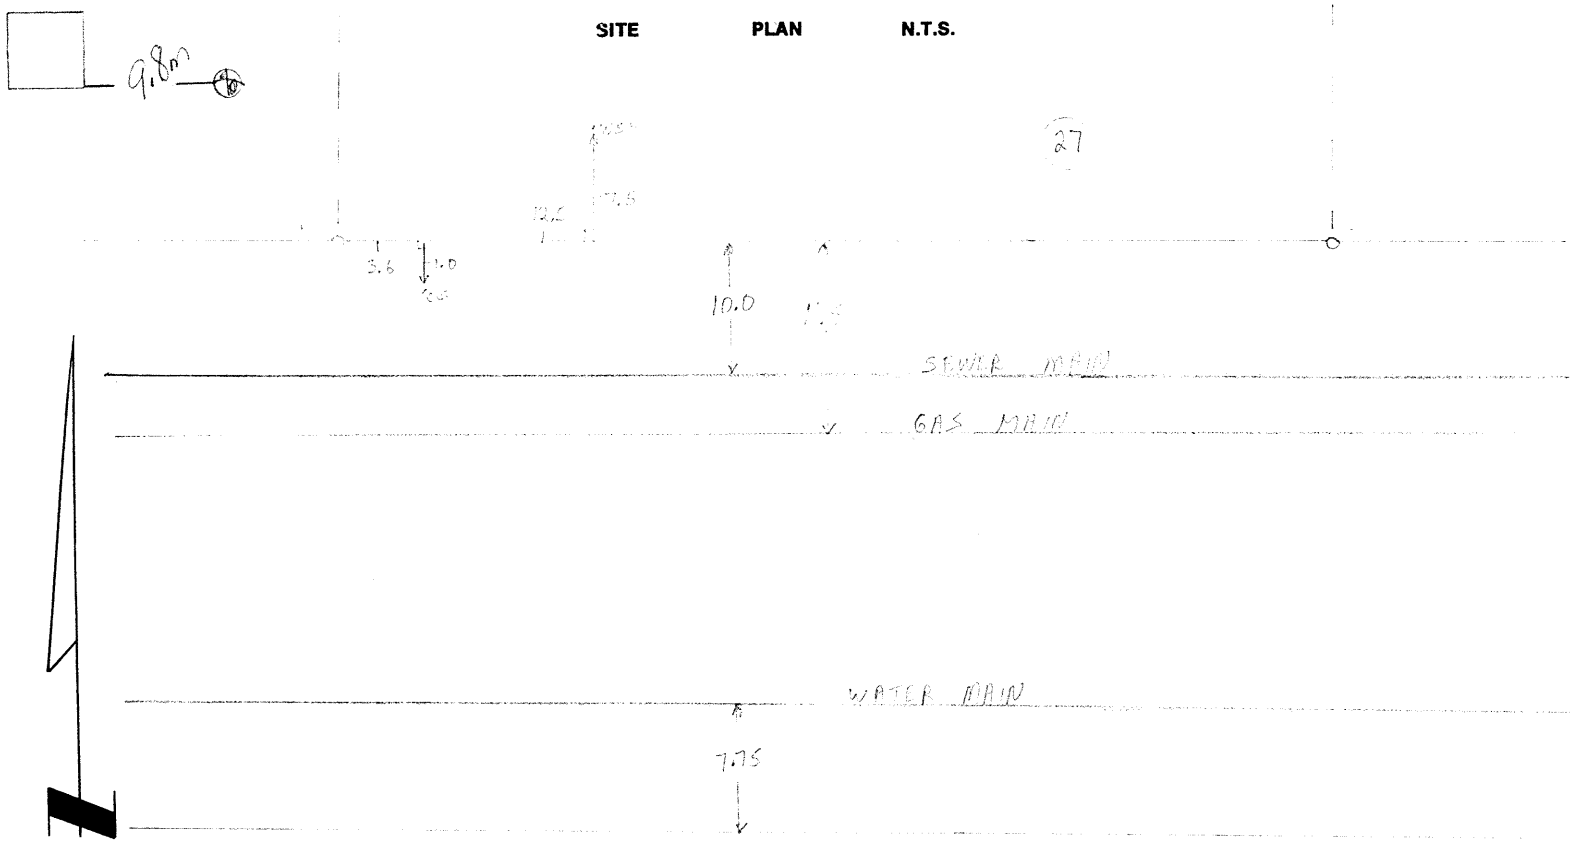
SITE PLAN N.T.S.