# City of Prince George
## HISTORY SHEET

SHEET NUMBER 8787 **Roll Number** 009008664 22200

**Legal:** LOT'S 117 BLOCK D.L. 754 PLAN ~~[illegible]~~

**Address:** 7756 NEWTON CRESENT

**Sanitary Connection:** # SIZE 4" MATERIAL AC INV. 2015 CONNECTED

**Water Connection** # SIZE 3/4" MATERIAL COPPER METER NONE CONNECTED

**Storm Connection:** # SIZE MATERIAL INV. CONNECTED

**Cash Receipt No's:** WATER SANITARY STORM

CURB FROM PROPERTY LINE 18' PAVEMENT WIDTH 30'

B.C. HYDRO 3' UNDERGROUND CONNECTION ✓

B.C. TELEPHONE 3' UNDERGROUND CONNECTION ✓

INLAND GAS 11.5'

**Information Sheets:**
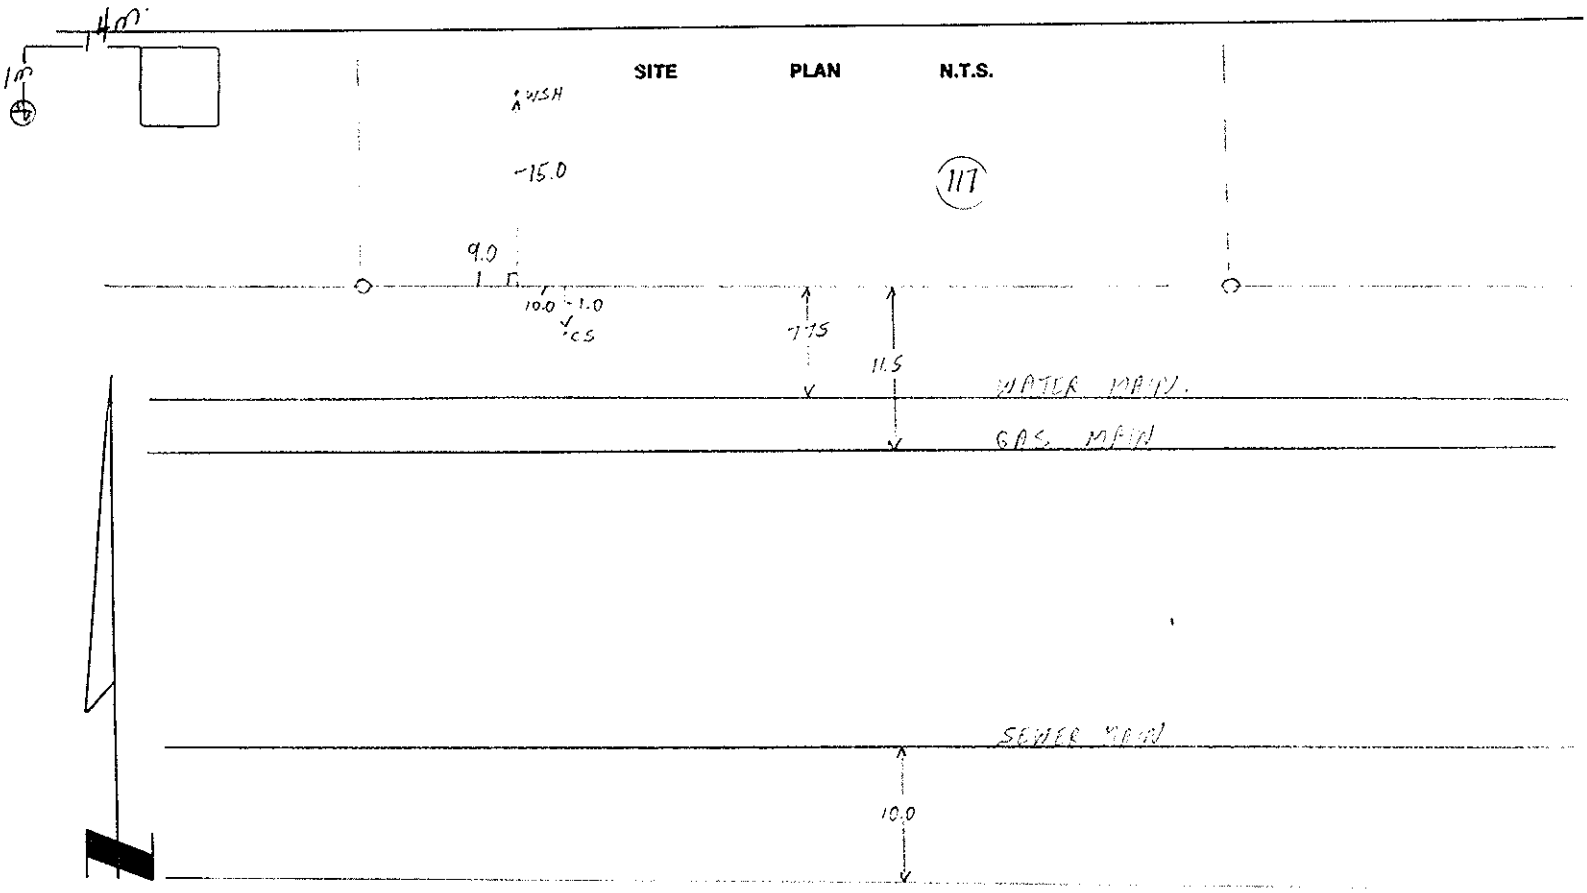
**Comments:**