City of Prince George
HISTORY SHEET

SHEET NUMBER № 2623 **Roll Number** 009037497

Legal: LOT'S 12 BLOCK D.L. 2424 PLAN 22129

Address: 2142 SPARROW

Sanitary Connection: # SIZE 100 mm MATERIAL PVC INV. 2.5M CONNECTED

Water Connection # SIZE 3/4" MATERIAL CW METER CONNECTED

Storm Connection: # SIZE MATERIAL INV. CONNECTED

Cash Receipt No's: WATER SANITARY STORM

CURB FROM PROPERTY LINE PAVEMENT WIDTH

B.C. HYDRO UNDERGROUND CONNECTION

B.C. TELEPHONE UNDERGROUND CONNECTION

INLAND GAS

Information Sheets:

Comments: The information contained herein is for [illegible] upon [illegible] water meter investigation.
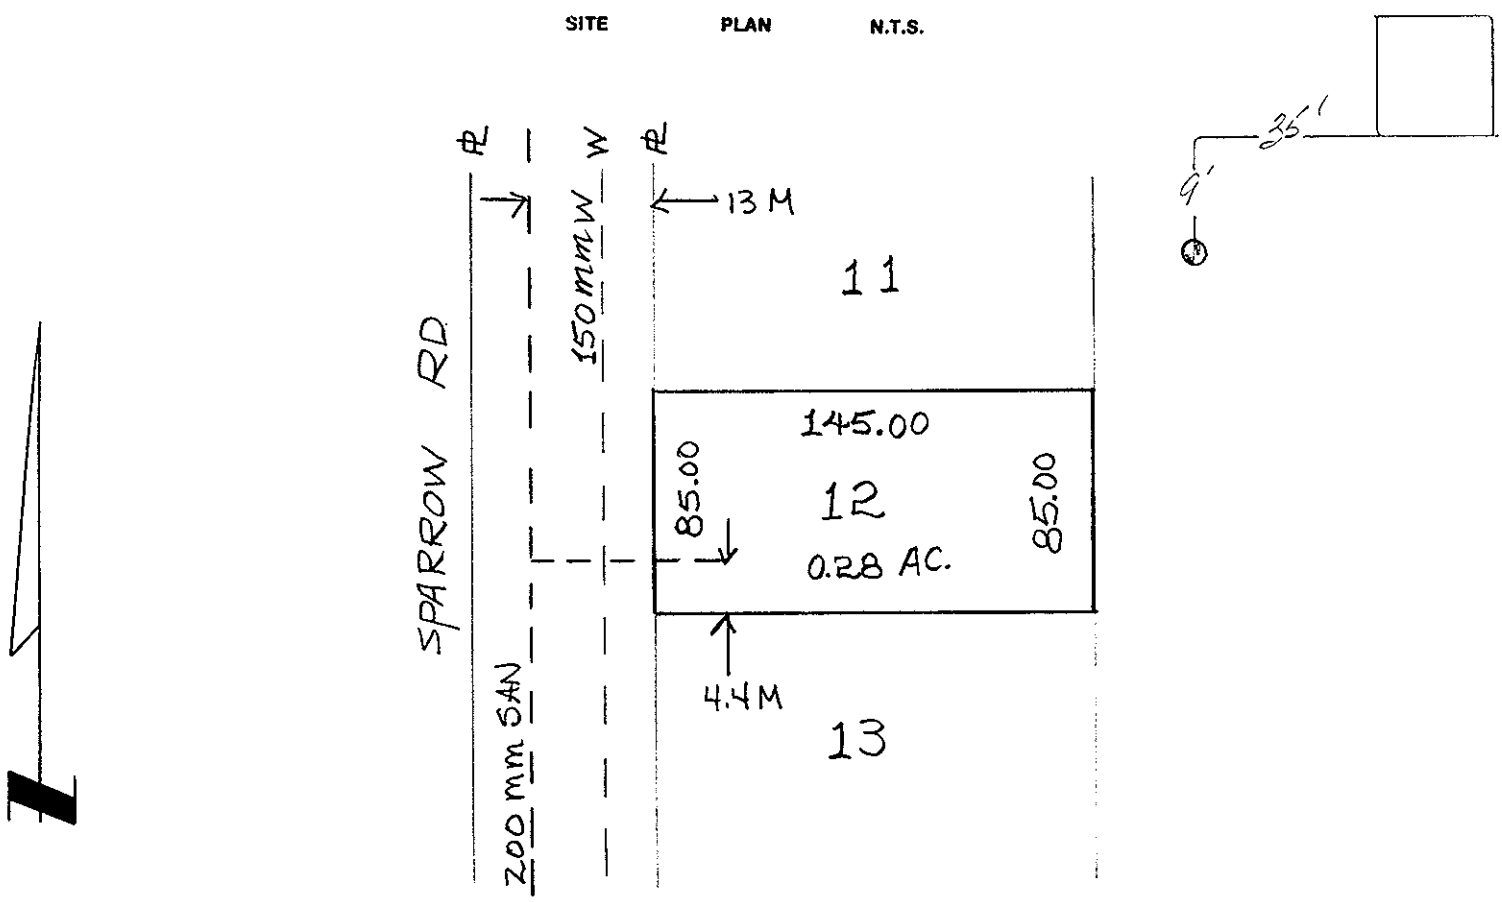
SITE PLAN N.T.S.