City of Prince George
HISTORY SHEET

00040491

FM

SHEET NUMBER **Roll Number**

Legal: LOT'S 36 BLOCK D.L. 482 PLAN 22108

Address: 4502 LAW AVE. 445 HUNTER ST.

Sanitary Connection: # SIZE 4" MATERIAL A.C. INV. CONNECTED YES

Water Connection # SIZE 3/4" MATERIAL Copper METER CONNECTED YES

Storm Connection: # SIZE MATERIAL INV. CONNECTED

Cash Receipt No's: WATER SANITARY STORM

CURB FROM PROPERTY LINE PAVEMENT WIDTH

B.C. HYDRO UNDERGROUND CONNECTION

B.C. TELEPHONE UNDERGROUND CONNECTION

INLAND GAS

Information Sheets:

Comments: WATER and Sanitary Conn. is Centred on lot
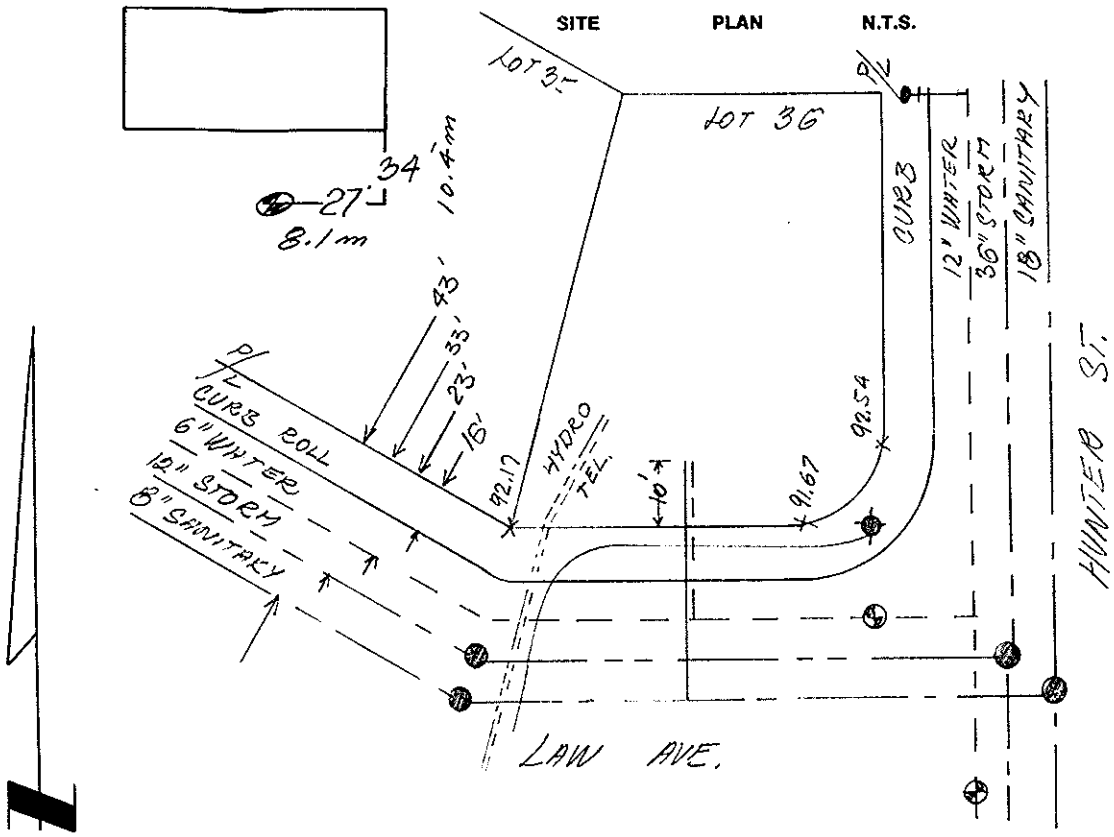
SITE PLAN N.T.S.