City of Prince George
HISTORY SHEET

SHEET NUMBER

Roll Number 009642822

Legal: LOT'S 56 BLOCK D.L. 2507 PLAN 22108

Address: 361 GRAHAM ST.

Sanitary Connection: # SIZE 4" MATERIAL A.C. INV. CONNECTED

Water Connection # SIZE 3/4" MATERIAL Copper METER CONNECTED

Storm Connection: # SIZE MATERIAL INV. CONNECTED

Cash Receipt No's: WATER SANITARY STORM

CURB FROM PROPERTY LINE PAVEMENT WIDTH

B.C. HYDRO UNDERGROUND CONNECTION

B.C. TELEPHONE UNDERGROUND CONNECTION

INLAND GAS

Information Sheets:

Comments:
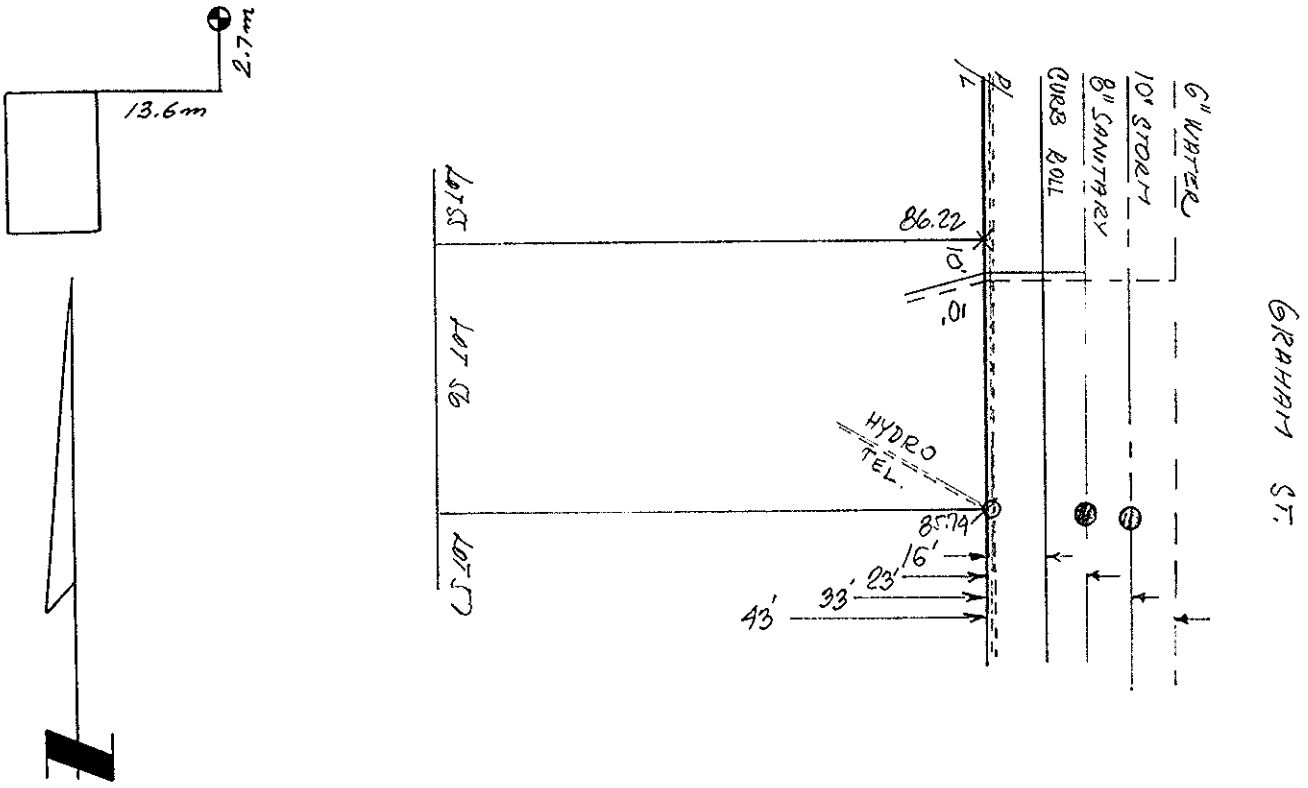
SITE PLAN N.T.S.