City of Prince George
HISTORY SHEET

SHEET NUMBER 7878 **Roll Number** 009056319

Legal: LOT'S 93 BLOCK D.L. 754 PLAN 22076

Address: 7779 PIEDMONT CRESENT

Sanitary Connection: # SIZE 4" MATERIAL AC INV. 2011 CONNECTED

Water Connection # SIZE 3/4" MATERIAL COPPER METER NONE CONNECTED

Storm Connection: # SIZE MATERIAL INV. CONNECTED

Cash Receipt No's: WATER SANITARY STORM

CURB FROM PROPERTY LINE 18' PAVEMENT WIDTH 30'

B.C. HYDRO 3' UNDERGROUND CONNECTION ✓

B.C. TELEPHONE 3' UNDERGROUND CONNECTION ✓

INLAND GAS 11'6"

Information Sheets:

Comments:
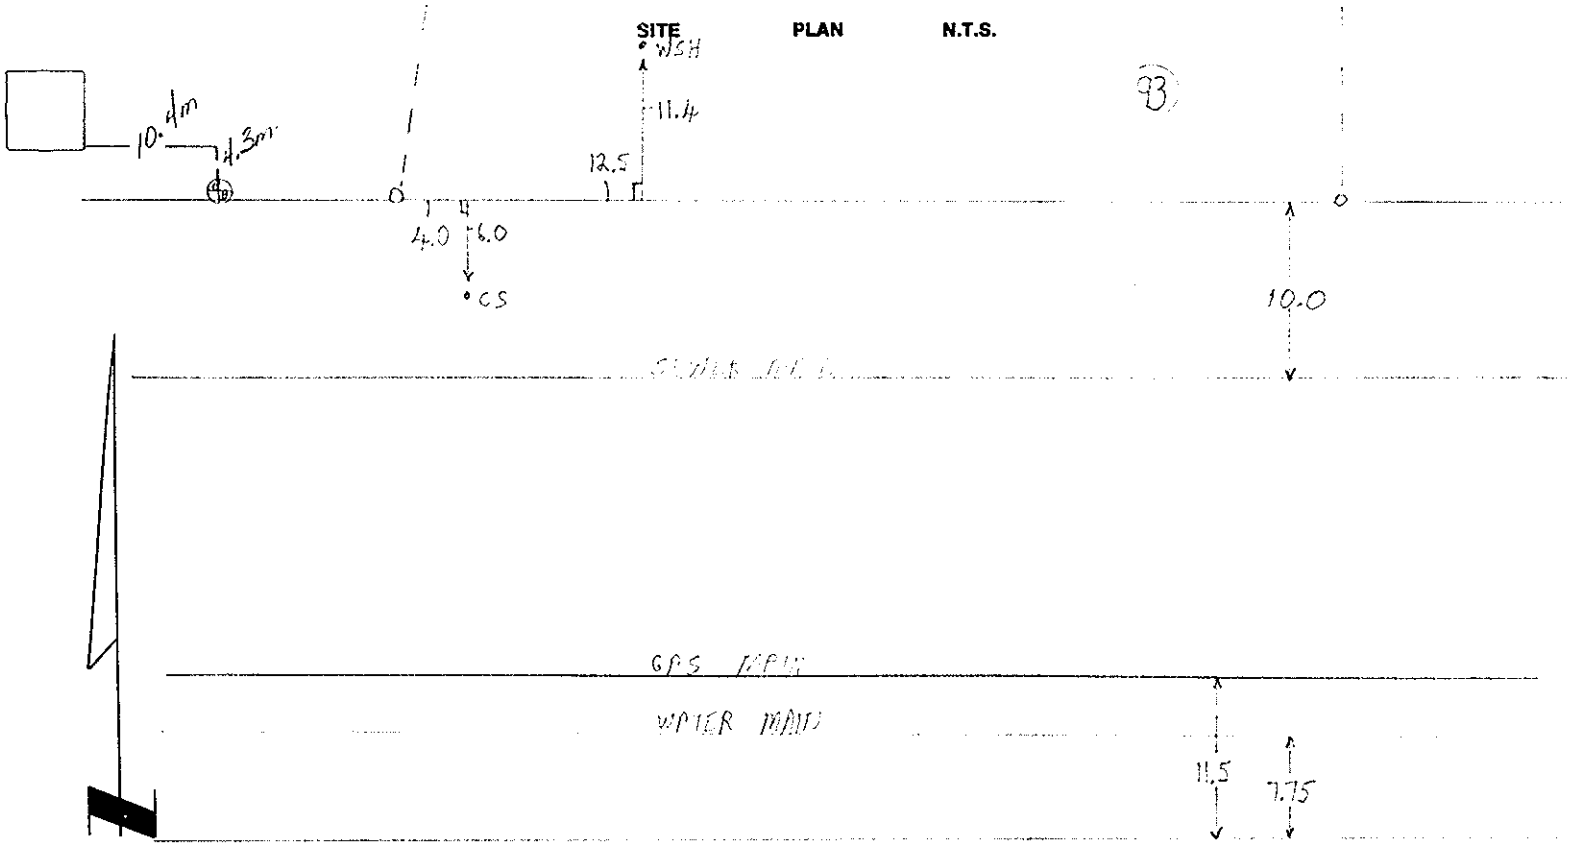
SITE PLAN N.T.S.