City of Prince George
HISTORY SHEET

SHEET NUMBER **Roll Number** 309219315

Legal: LOT'S A BLOCK D.L. 754 PLAN 21806

Address: 7240 IMPERIAL CRES

Sanitary Connection: # SIZE 100 mm MATERIAL A.C. INV. CONNECTED

Water Connection # SIZE 20 mm MATERIAL Cu. METER CONNECTED

Storm Connection: # SIZE MATERIAL INV. CONNECTED

Cash Receipt No's: WATER SANITARY STORM

CURB FROM PROPERTY LINE 5.486 m PAVEMENT WIDTH 9.144 m.

B.C. HYDRO UNDERGROUND CONNECTION

B.C. TELEPHONE UNDERGROUND CONNECTION

INLAND GAS

Information Sheets:

Comments: Sanitary Water Apparently Common Trenched
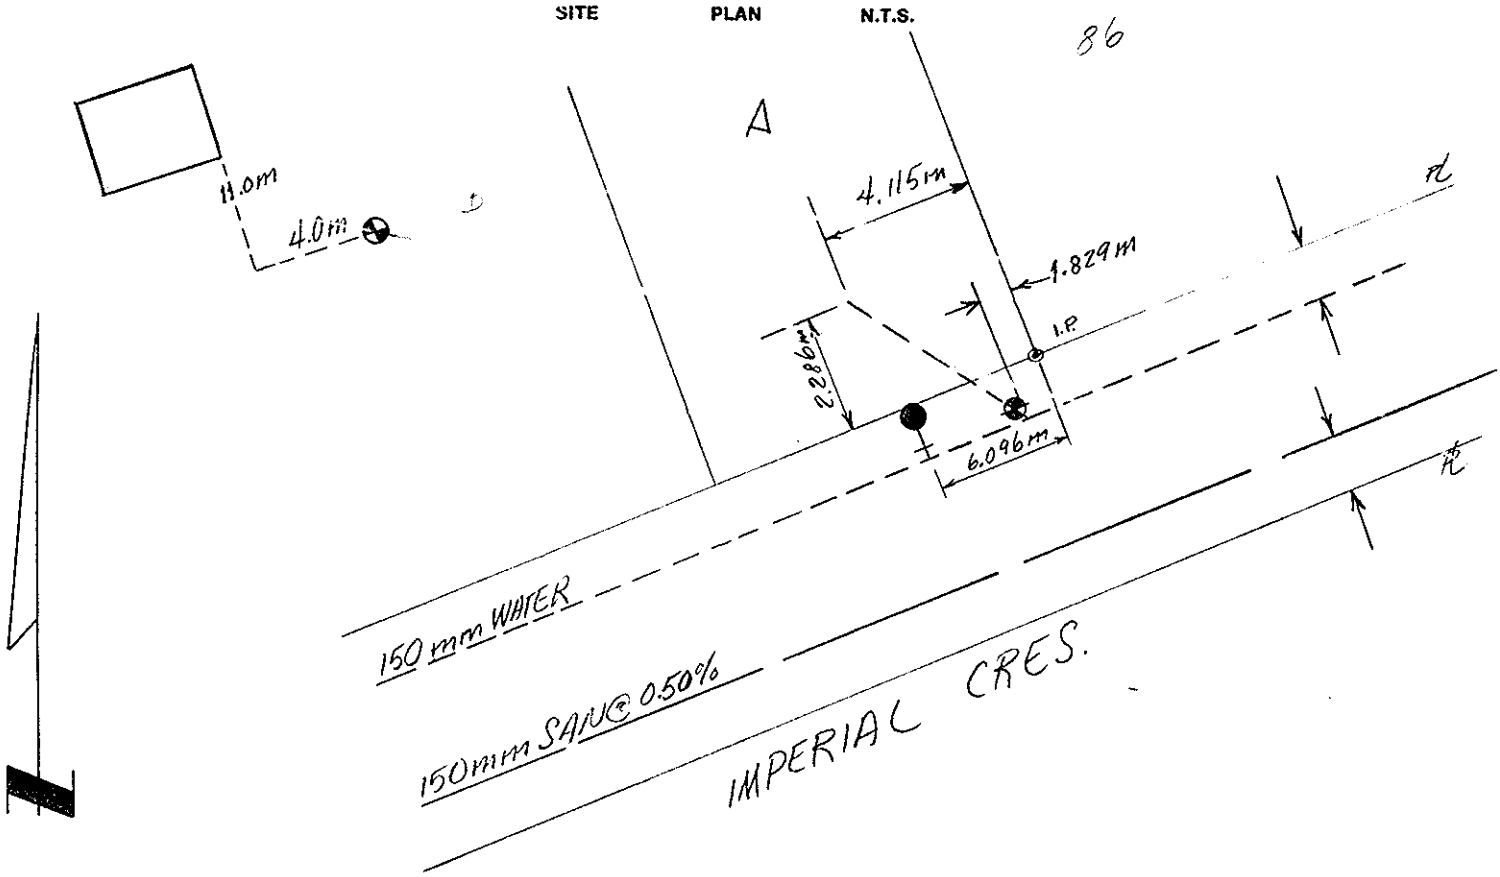
SITE PLAN N.T.S.