City of Prince George
HISTORY SHEET

SHEET NUMBER 7708 **Roll Number** 009266267

Legal: LOT'S 4 BLOCK D.L. 754 PLAN 21798

Address: 7545 JUILLIARD PL.

Sanitary Connection: # SIZE 4"ϕ MATERIAL A.C. INV. CONNECTED

Water Connection # SIZE 3/4"ϕ MATERIAL Cu. METER CONNECTED

Storm Connection: # SIZE MATERIAL INV. CONNECTED

Cash Receipt No's: WATER SANITARY STORM

CURB FROM PROPERTY LINE 18' PAVEMENT WIDTH 30'

B.C. HYDRO UNDERGROUND CONNECTION

B.C. TELEPHONE UNDERGROUND CONNECTION

INLAND GAS

Information Sheets:

Comments:
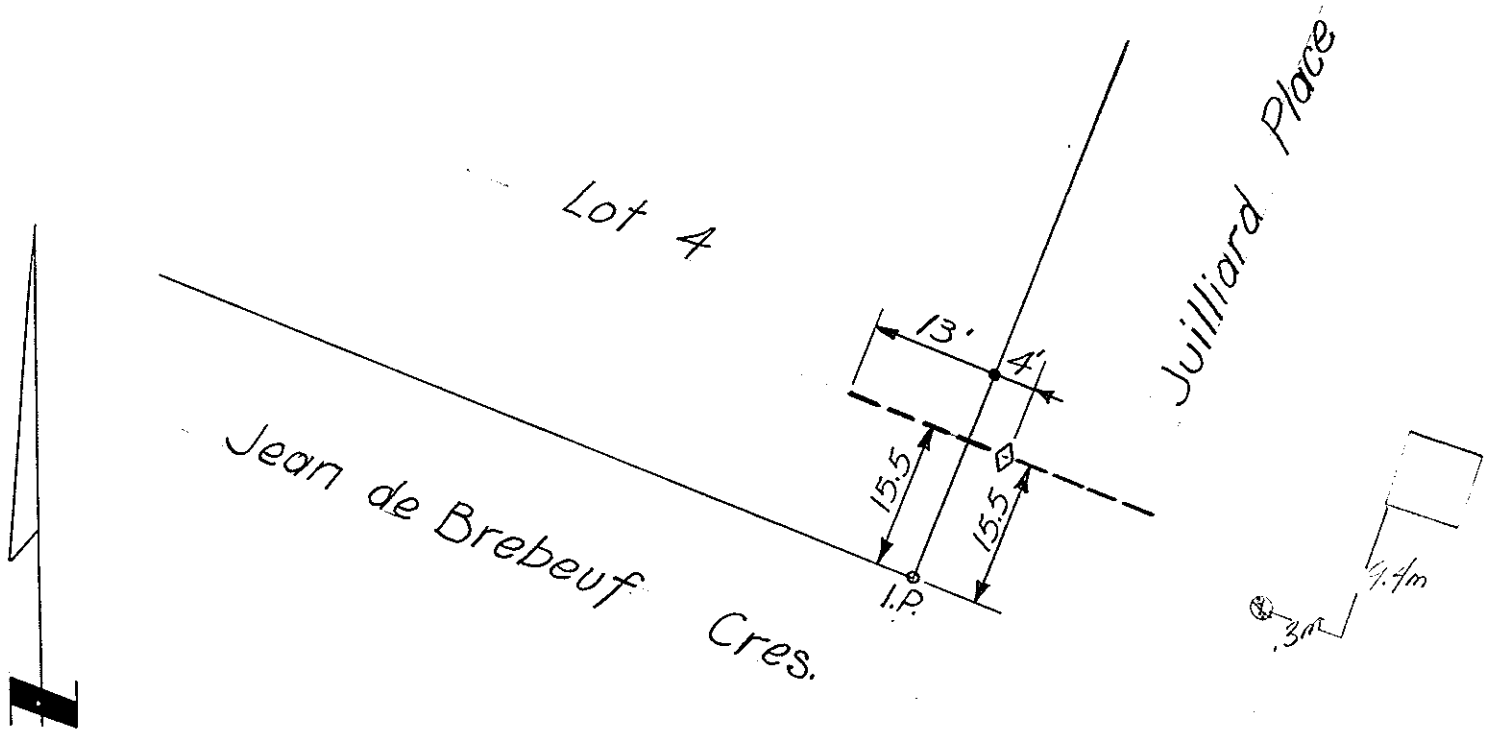
SITE PLAN N.T.S.