City of Prince George
HISTORY SHEET

S

SHEET NUMBER **6406** **Roll Number**

Legal: LOT'S 113 BLOCK D.L. 4046 PLAN 21748

Address: 2900 NIXON CR.

Sanitary Connection: # 14017 SIZE 4" MATERIAL INV. CONNECTED

Water Connection # SIZE 3/4" MATERIAL COPPER METER CONNECTED

Storm Connection: # SIZE MATERIAL INV. CONNECTED

Cash Receipt No's: WATER SANITARY STORM

CURB FROM PROPERTY LINE PAVEMENT WIDTH

B.C. HYDRO UNDERGROUND CONNECTION

B.C. TELEPHONE UNDERGROUND CONNECTION

INLAND GAS

Information Sheets:

Comments: HID WATER SERVICE - ON NORTH CORNER
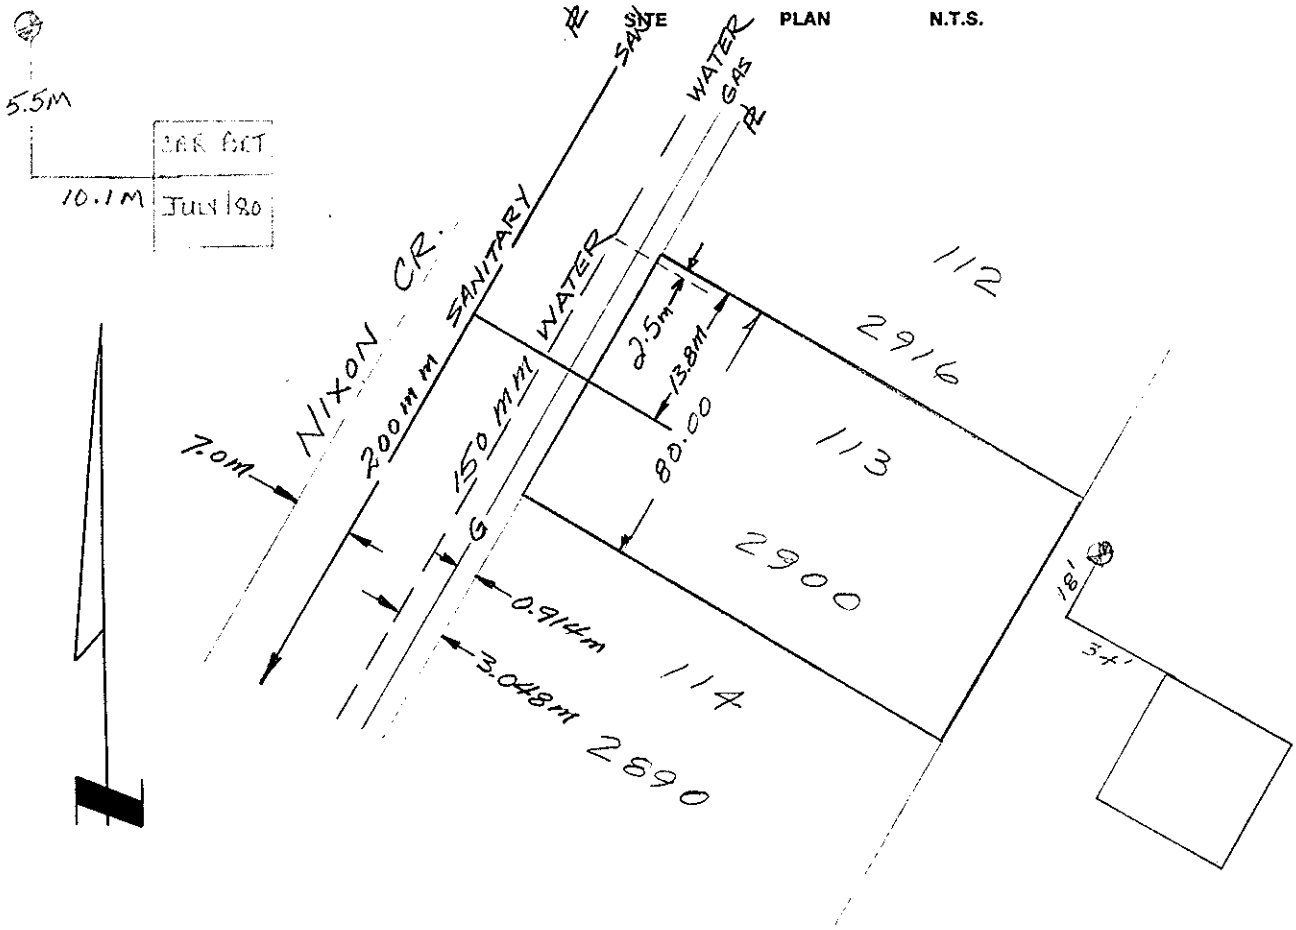
SITE PLAN N.T.S.