# City of Prince George
## HISTORY SHEET

S

SHEET NUMBER **6403** Roll Number

**Legal:** LOT'S 110 BLOCK D.L. 4046 PLAN 21748

**Address:** 2940 NIXON CR.

**Sanitary Connection:** # 14018 SIZE 4" MATERIAL INV. CONNECTED

**Water Connection** # SIZE 3/4" MATERIAL Copper METER CONNECTED

**Storm Connection:** # SIZE MATERIAL INV. CONNECTED

**Cash Receipt No's:** WATER SANITARY STORM

CURB FROM PROPERTY LINE PAVEMENT WIDTH

B.C. HYDRO UNDERGROUND CONNECTION

B.C. TELEPHONE UNDERGROUND CONNECTION

INLAND GAS

**Information Sheets:**

**Comments:** 110 WATER SERVICE - 4' NORTH of South P. & 1' OFF P.
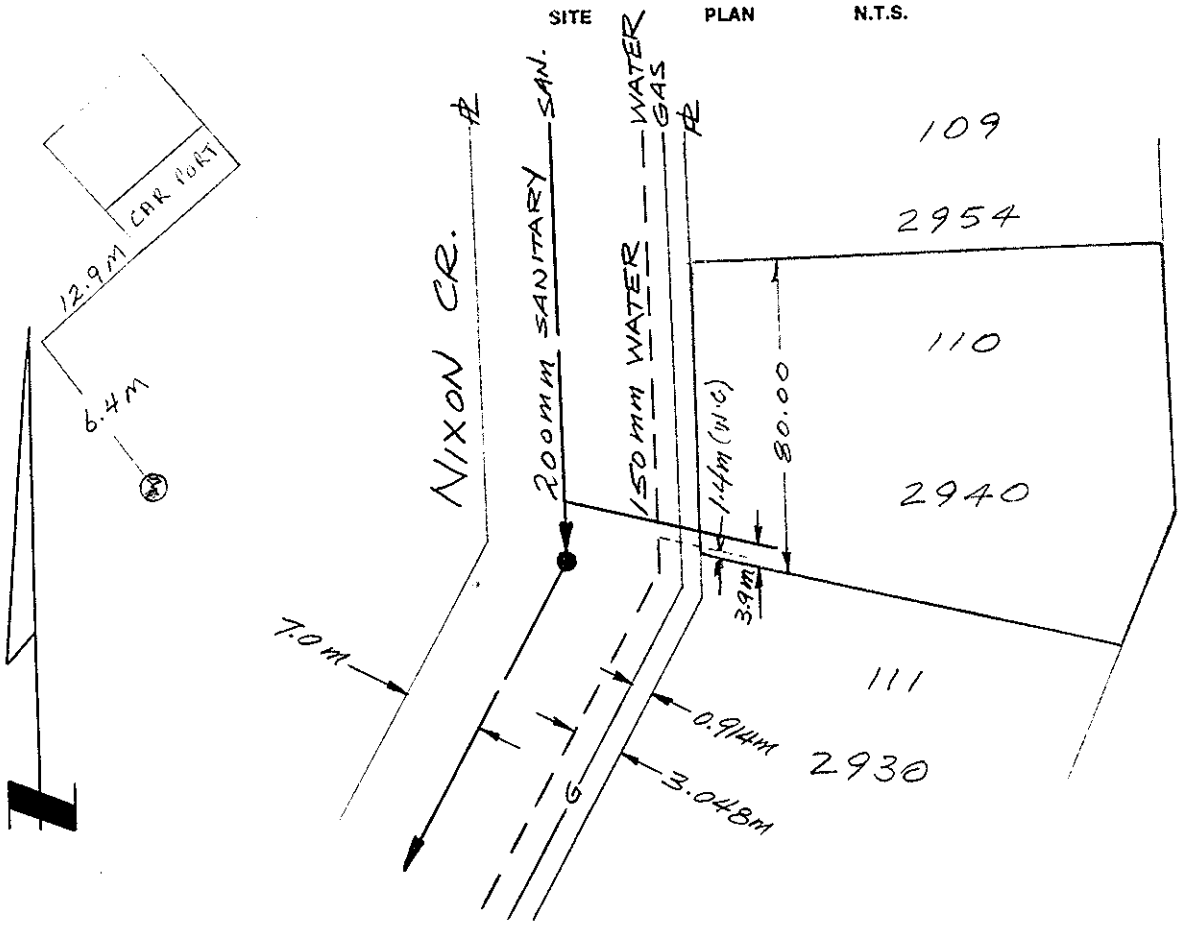
SITE PLAN N.T.S.