# City of Prince George
## HISTORY SHEET

SHEET NUMBER 6402 Roll Number

**Legal:** LOT'S 109 BLOCK D.L. 4046 PLAN 21748

**Address:** 2235 CALVIN RD.

**Sanitary Connection:** # 14019 SIZE 4" MATERIAL INV. CONNECTED

**Water Connection** # SIZE 3/4 MATERIAL copper METER CONNECTED

**Storm Connection:** # SIZE MATERIAL INV. CONNECTED

**Cash Receipt No's:** WATER SANITARY STORM

CURB FROM PROPERTY LINE PAVEMENT WIDTH

B.C. HYDRO UNDERGROUND CONNECTION

B.C. TELEPHONE UNDERGROUND CONNECTION

INLAND GAS

**Information Sheets:**
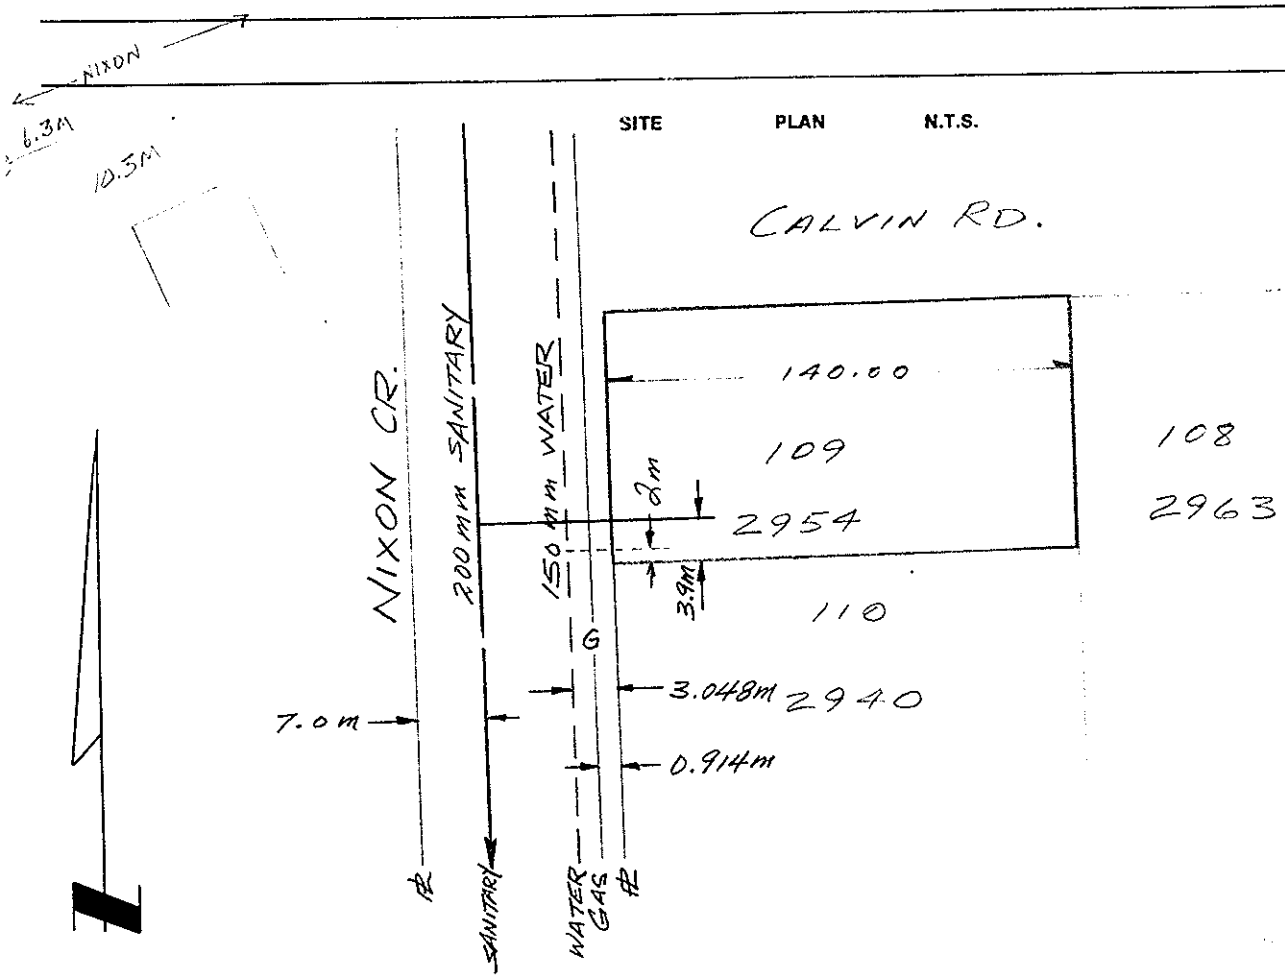
**Comments:** 1110 WATER SERVICE - 4' NORTH OF HYDRANT