009316299
JK

City of Prince George
HISTORY SHEET

SHEET NUMBER **8110** **Roll Number** 165.020

Legal: LOT'S D BLOCK ~~26~~ D.L. 417 PLAN 21640

Address: 2273 Royal Crescent

Sanitary Connection: # SIZE 4" MATERIAL AC INV. CONNECTED 1976

Water Connection # SIZE 3/4" MATERIAL CU METER CONNECTED 1976

Storm Connection: # SIZE MATERIAL INV. CONNECTED

Cash Receipt No's: WATER pd. SANITARY pd. STORM

CURB FROM PROPERTY LINE PAVEMENT WIDTH

B.C. HYDRO UNDERGROUND CONNECTION

B.C. TELEPHONE UNDERGROUND CONNECTION

INLAND GAS

Information Sheets:

Comments: sold by Village as fully serviced lot.

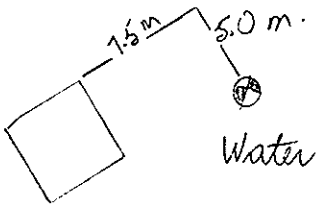

SITE PLAN N.T.S.

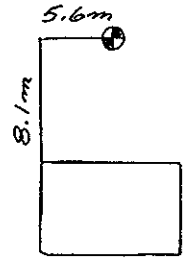

Water and Sewer from Royal Crescent
approx. middle of lot