City of Prince George
HISTORY SHEET

D5

SHEET NUMBER **Roll Number** 009369503

Legal: LOT'S 338 BLOCK D.L. 261 PLAN 21607

Address: 2284 SHEARER CRESCENT

Sanitary Connection: # 9528 SIZE 100 mm MATERIAL A.C. INV. 71.73 CONNECTED

Water Connection # 9528 SIZE 20 mm MATERIAL Copper METER CONNECTED

Storm Connection: # SIZE MATERIAL INV. CONNECTED

Cash Receipt No's: WATER SANITARY STORM

CURB FROM PROPERTY LINE 4.877 m PAVEMENT WIDTH 10.363 m

B.C. HYDRO U/G UNDERGROUND CONNECTION

B.C. TELEPHONE U/G UNDERGROUND CONNECTION

INLAND GAS AS SHOWN

Information Sheets: WITH THAW WIRE!

Comments: WATER and SANITARY CONN. IS CENTRED ON LOT
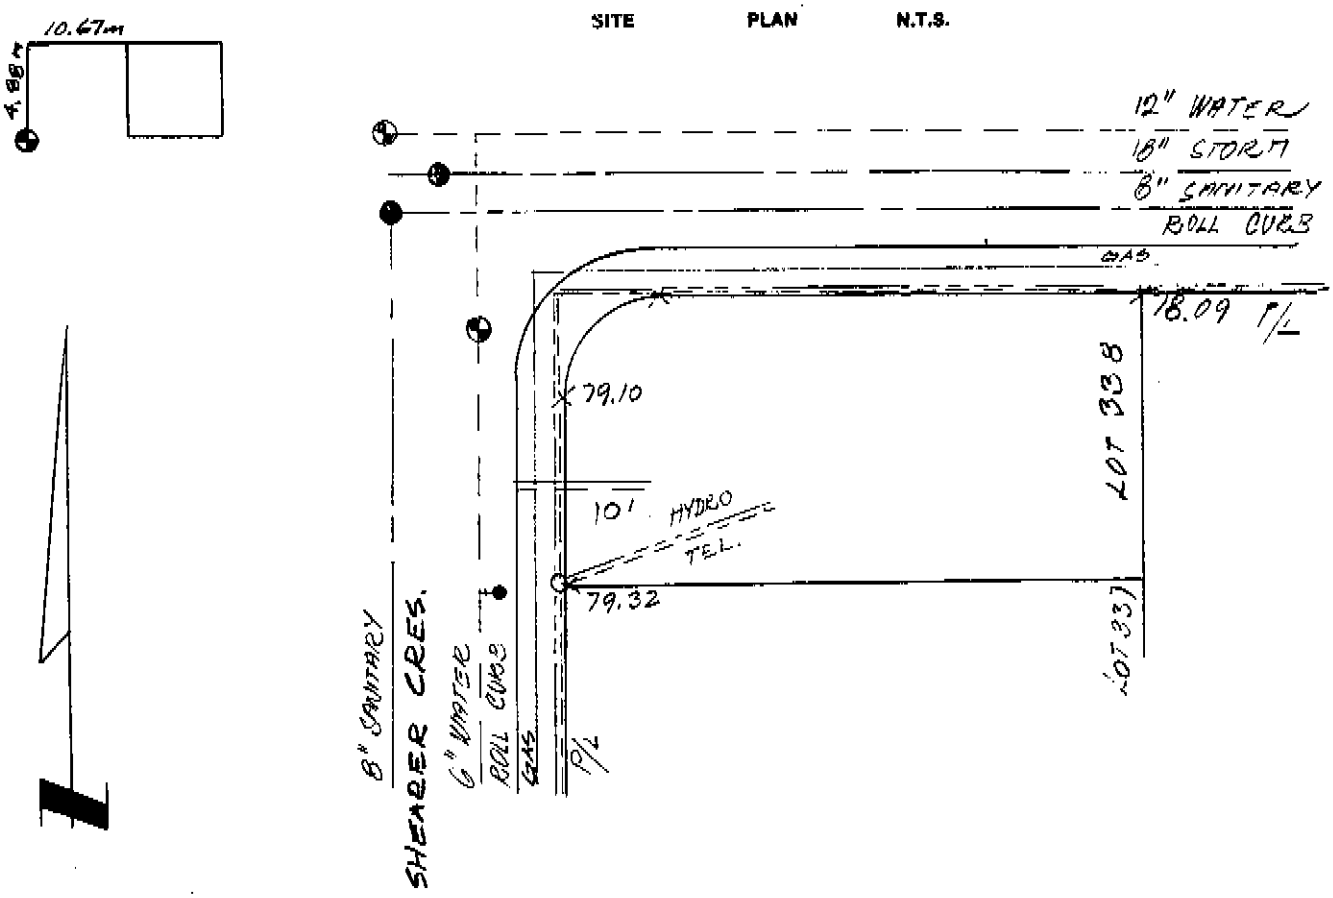
SITE PLAN N.T.S.