City of Prince George
HISTORY SHEET

009425900
009425888
009425861 JL

SHEET NUMBER **108** **Roll Number** 558-000

Legal: LOT'S 14-16 BLOCK 28 D.L. 343 PLAN 1268
STORM ALEY.

Address: 750 SECOND AVE
PRINCE GEORGE B.C. 750 SECOND AVE.

Sanitary Connection: # 2073 SIZE MATERIAL INV. CONNECTED —

Water Connection # — SIZE MATERIAL METER CONNECTED —

Storm Connection: # — SIZE MATERIAL INV. CONNECTED —

Cash Receipt No's: WATER — SANITARY — STORM —

CURB FROM PROPERTY LINE 10' PAVEMENT WIDTH 60'

B.C. HYDRO O.H UNDERGROUND CONNECTION —

B.C. TELEPHONE O.H UNDERGROUND CONNECTION —

INLAND GAS ON LANE 2" Φ MAIN.

Information Sheets: —

Comments: THE INFORMATION CONTAINED HEREIN IS FOR INTERNAL USE ONLY. NOT TO BE RELIED UPON UNLESS CONFIRMED BY SITE INSPECTION AND/OR INVESTIGATION.
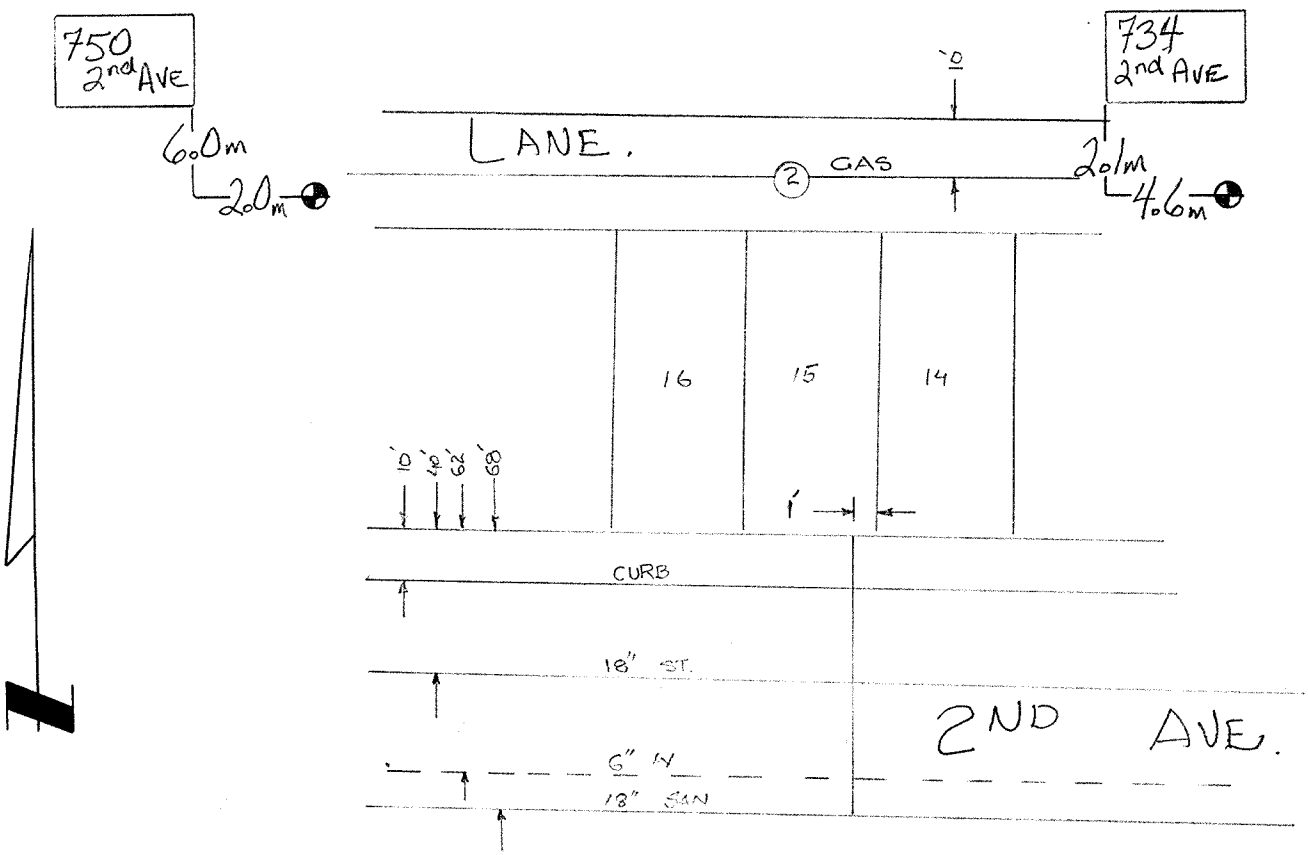
SITE PLAN N.T.S.