City of Prince George
HISTORY SHEET

SHEET NUMBER **Roll Number** 009444718

Legal: LOT'S 4 BLOCK D.L. 2611 PLAN 21607

Address: 2431 RUSH PLACE

Sanitary Connection: # 9204 SIZE 4" MATERIAL A.C. INV. 78.87 CONNECTED

Water Connection # 9204 SIZE 3/4" MATERIAL Copper METER CONNECTED

Storm Connection: # SIZE MATERIAL INV. CONNECTED

Cash Receipt No's: WATER SANITARY STORM

CURB FROM PROPERTY LINE PAVEMENT WIDTH

B.C. HYDRO UNDERGROUND CONNECTION

B.C. TELEPHONE UNDERGROUND CONNECTION

INLAND GAS

Information Sheets:

Comments: WATER + SAN. CONN. is 6' S. OF N P/L.

HYDRO + TEL. " is 10' S. OF N P/L.
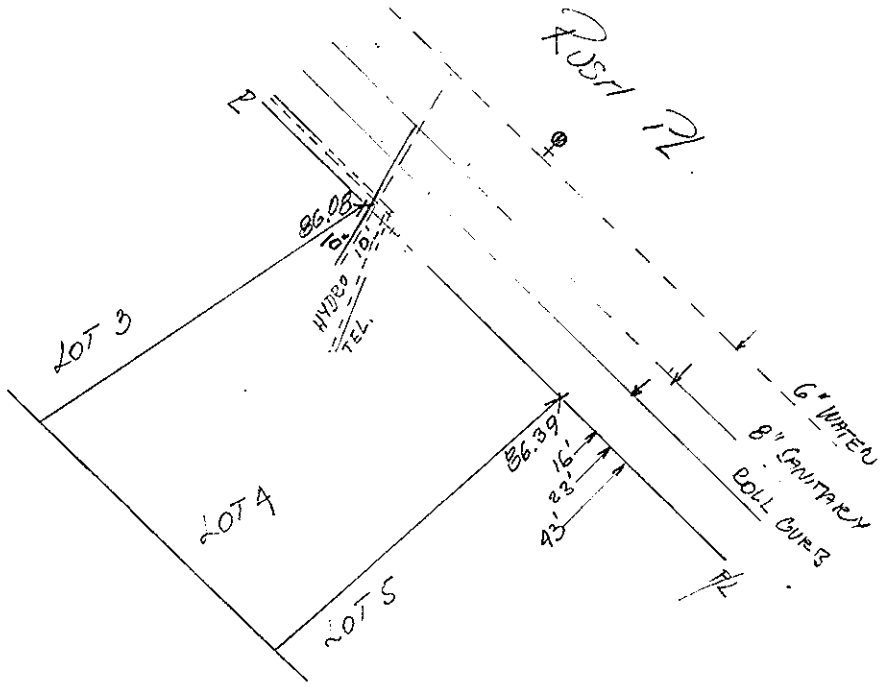
SITE PLAN N.T.S.