City of Prince George
HISTORY SHEET

009446621
009446656

SHEET NUMBER **179** **Roll Number** 791-000

Legal: LOT'S 11-12 BLOCK 38 D.L. 343 PLAN 1268

Address: C G PRODUCTS HOLDINGS LTD. 823 CARNAVON ST. NEW WESTMINISTER B.C. C/O THIRD AVE.

Sanitary Connection: # 4432 SIZE 4" MATERIAL ACS. INV. 1860.22 CONNECTED —

Water Connection # 4198 SIZE 3/4" MATERIAL Cu METER — CONNECTED —

Storm Connection: # SIZE MATERIAL INV. CONNECTED —

Cash Receipt No's: WATER 2577 SANITARY 2576 STORM

CURB FROM PROPERTY LINE 10' PAVEMENT WIDTH 60'

B.C. HYDRO O.H UNDERGROUND CONNECTION —

B.C. TELEPHONE O.H. UNDERGROUND CONNECTION —

INLAND GAS ON LANE 2" ϕ MAIN.

Information Sheets: 28.

Comments:

THE INFORMATION CONTAINED HEREIN IS FOR INTERNAL USE ONLY. NOT TO BE RELIED UPON UNLESS CONFIRMED BY SITE INSPECTION AND/OR INVESTIGATION.
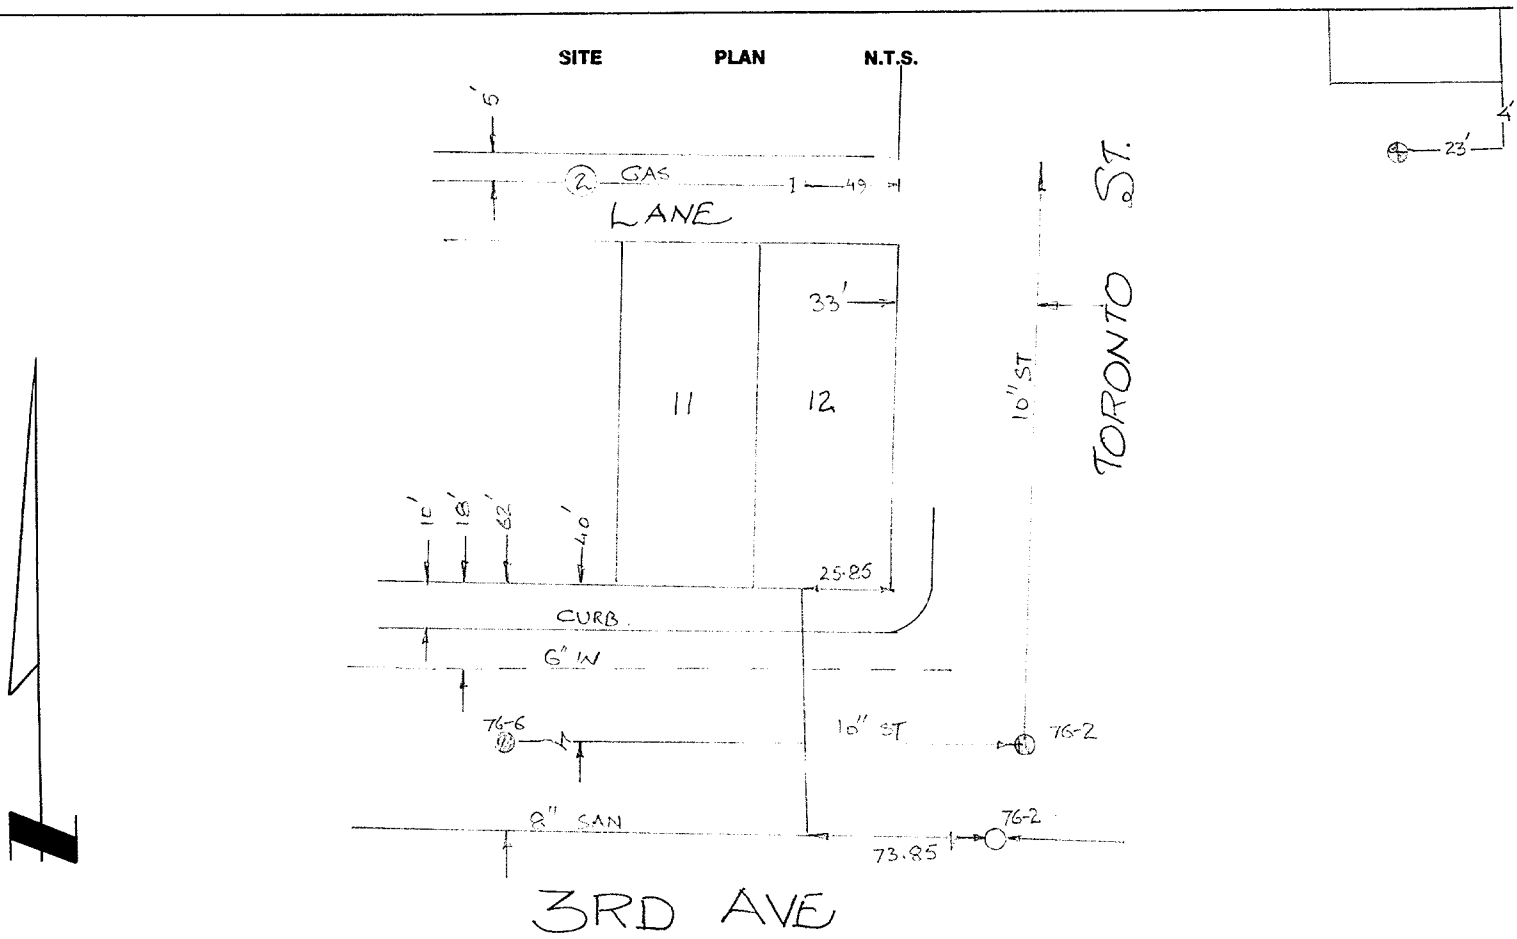
SITE PLAN N.T.S.