00945 3288
00945 3270
00945 3261

City of Prince George
HISTORY SHEET

SHEET NUMBER **72** **Roll Number** 429-000

Legal: LOT'S 16-19 BLOCK 21 D.L. 343 PLAN 1268

Address: FRONTIER RENTALS LTD. 1270 SECOND AVE PRINCE GEORGE B.C.

Sanitary Connection: # 4368 SIZE 4" MATERIAL AC INV. 1871.21 CONNECTED —

Water Connection # 2486 4106 SIZE 1" MATERIAL Cu METER CONNECTED ✓

Storm Connection: # 142 SIZE 4" MATERIAL INV. 68.60 CONNECTED —

Cash Receipt No's: WATER 2276 SANITARY 2399 STORM 2574.

CURB FROM PROPERTY LINE 10' PAVEMENT WIDTH 60'

B.C. HYDRO O.H. UNDERGROUND CONNECTION —

B.C. TELEPHONE O.H. UNDERGROUND CONNECTION —

INLAND GAS ON LANE 2" ϕ MAIN.

Information Sheets: —

Comments:

THE INFORMATION CONTAINED HEREIN IS FOR INTERNAL USE ONLY. NOT TO BE RELIED UPON UNLESS CONFIRMED BY SITE INSPECTION AND/OR INVESTIGATION.
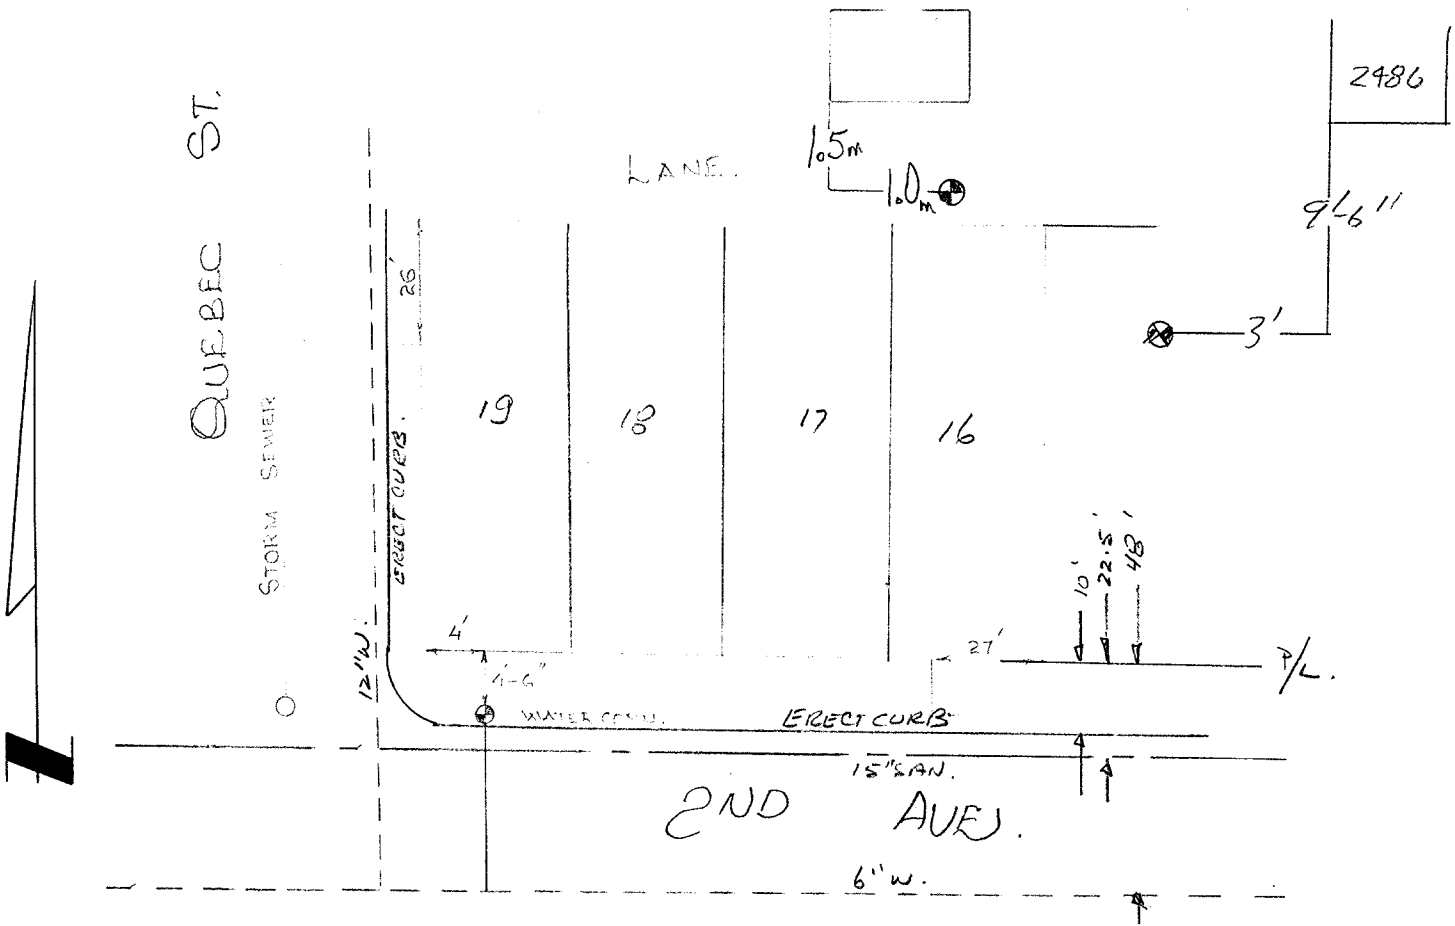
SITE PLAN N.T.S.