City of Prince George
HISTORY SHEET

009453423
0094 53407
009453385
00945 3431
009453415

SHEET NUMBER **115** **Roll Number** 581-000

Legal: LOT'S 10-14 BLOCK 29 D.L. 343 PLAN 1268

Address: (640 SECOND AVE.)

Sanitary Connection: # 2077 SIZE MATERIAL INV. CONNECTED —

Water Connection # 16 SIZE 3/4" MATERIAL Cu METER CONNECTED —

Storm Connection: # — SIZE MATERIAL INV. CONNECTED —

Cash Receipt No's: WATER — SANITARY 377 STORM

CURB FROM PROPERTY LINE 10' PAVEMENT WIDTH 60'

B.C. HYDRO O.H UNDERGROUND CONNECTION

B.C. TELEPHONE O.H UNDERGROUND CONNECTION

INLAND GAS ON LANE 2" ϕ MAIN.

Information Sheets: —

Comments: THE INFORMATION CONTAINED HEREIN IS FOR INTERNAL USE ONLY. NOT TO BE RELIED UPON UNLESS CONFIRMED BY SITE INSPECTION AND/OR INVESTIGATION.
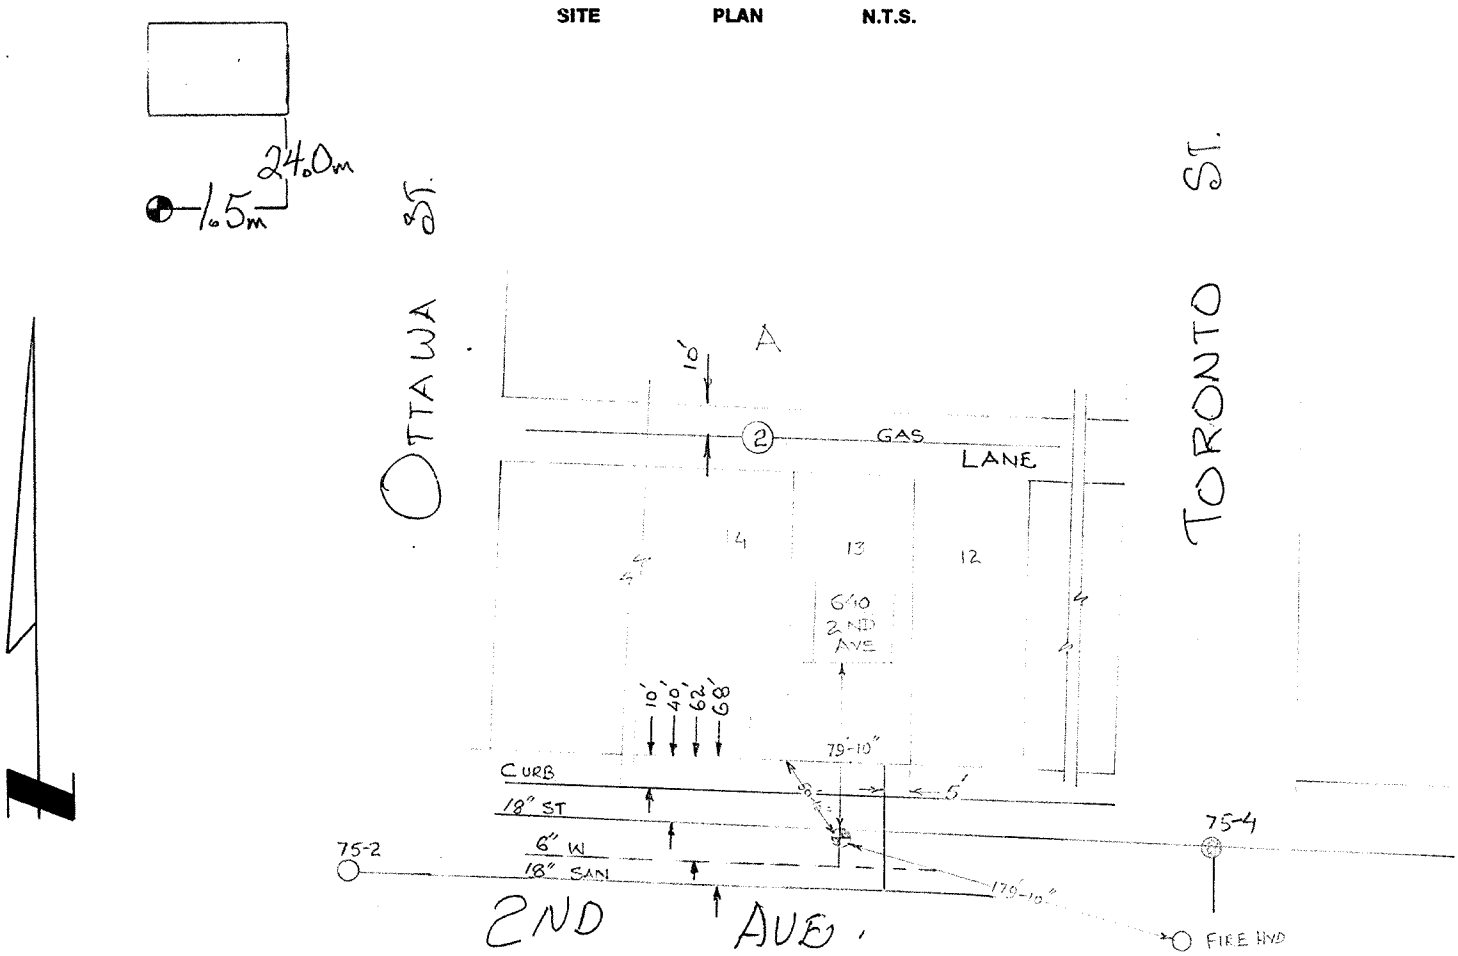
SITE PLAN N.T.S.