City of Prince George
HISTORY SHEET

009464069
009464093
009464123
009464158
009464182

SHEET NUMBER **204** **Roll Number** 846-000

Legal: LOT'S 6-10 BLOCK 41 D.L. 343 PLAN 1268

Address: 945 2ND AVE.

Sanitary Connection: # 7698 SIZE 4" MATERIAL ACR. INV. 59.70 CONNECTED –

Water Connection # 7715 SIZE 1" MATERIAL Cu METER # 448 CONNECTED –

Storm Connection: # – SIZE MATERIAL INV. CONNECTED –

Cash Receipt No's: WATER 206 SANITARY 205 STORM

CURB FROM PROPERTY LINE 10' PAVEMENT WIDTH 60'

B.C. HYDRO O.H. UNDERGROUND CONNECTION –

B.C. TELEPHONE O.H. UNDERGROUND CONNECTION –

INLAND GAS IN LANE 2" @ MAIN.

Information Sheets: 1910

Comments:

The information contained herein is for internal use only. Not to be relied upon unless confirmed by site inspection and/or investigation.
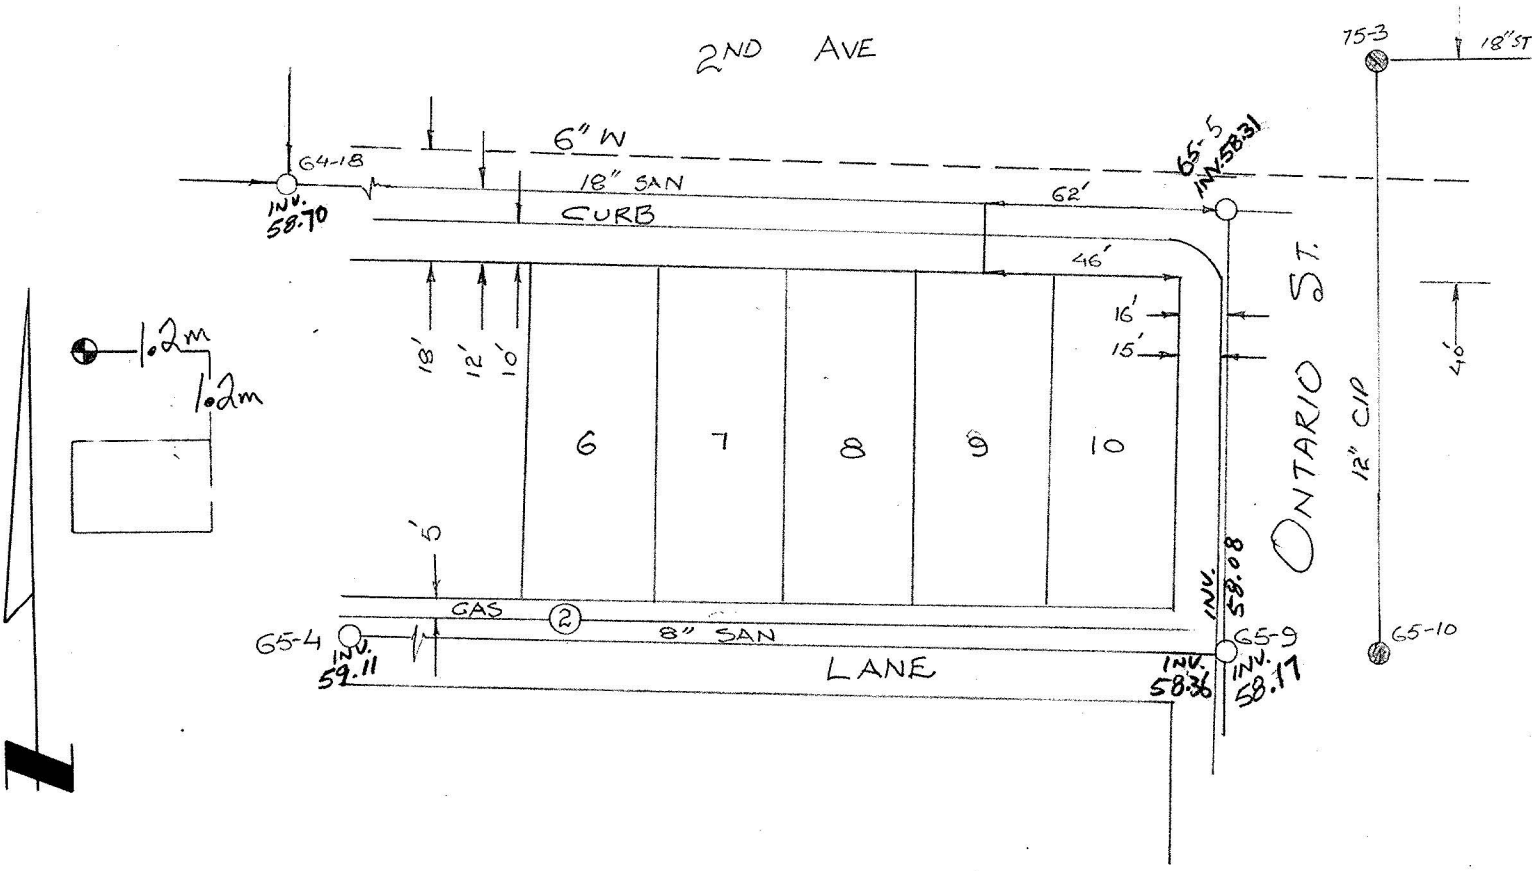
SITE PLAN N.T.S.