City of Prince George
HISTORY SHEET

SHEET NUMBER 7700 **Roll Number** 009473 050

Legal: LOT'S 100 BLOCK D.L. 754 PLAN 21540

Address: 7275 IMPERIAL CRES.

Sanitary Connection: # SIZE 4" ϕ MATERIAL A.C. INV. CONNECTED

Water Connection # SIZE 3/4" ϕ MATERIAL Cu METER CONNECTED

Storm Connection: # SIZE MATERIAL INV. CONNECTED

Cash Receipt No's: WATER SANITARY STORM

CURB FROM PROPERTY LINE 18' PAVEMENT WIDTH 30'

B.C. HYDRO UNDERGROUND CONNECTION

B.C. TELEPHONE UNDERGROUND CONNECTION

INLAND GAS

Information Sheets:

Comments:
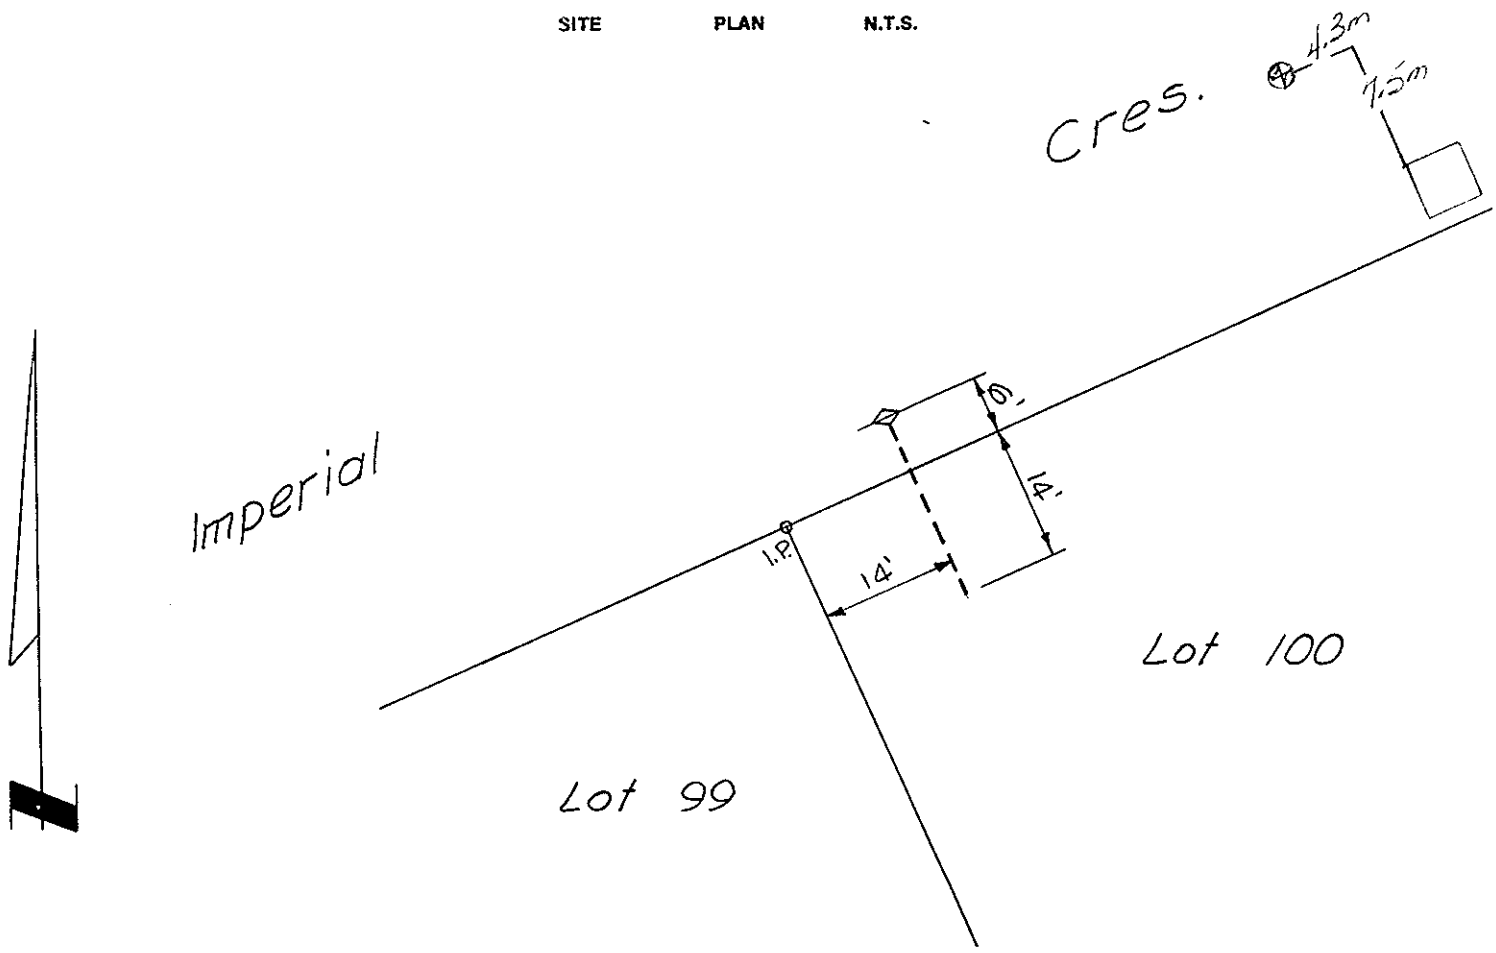
SITE PLAN N.T.S.