City of Prince George
HISTORY SHEET

SHEET NUMBER **Roll Number** 009506314

Legal: LOT'S 74 BLOCK D.L. 2610 PLAN 21450

Address: 439 Voyageur Dr.

Sanitary Connection: # 9073 SIZE 100mm MATERIAL A.C INV. CONNECTED

Water Connection # SIZE 20mm MATERIAL Cu METER CONNECTED

Storm Connection: # SIZE MATERIAL INV. CONNECTED

Cash Receipt No's: WATER SANITARY STORM

CURB FROM PROPERTY LINE 4.877m PAVEMENT WIDTH 10.363m

B.C. HYDRO UNDERGROUND UNDERGROUND CONNECTION YES

B.C. TELEPHONE UNDERGROUND UNDERGROUND CONNECTION YES.

INLAND GAS AS SHOWN

Information Sheets:

Comments:
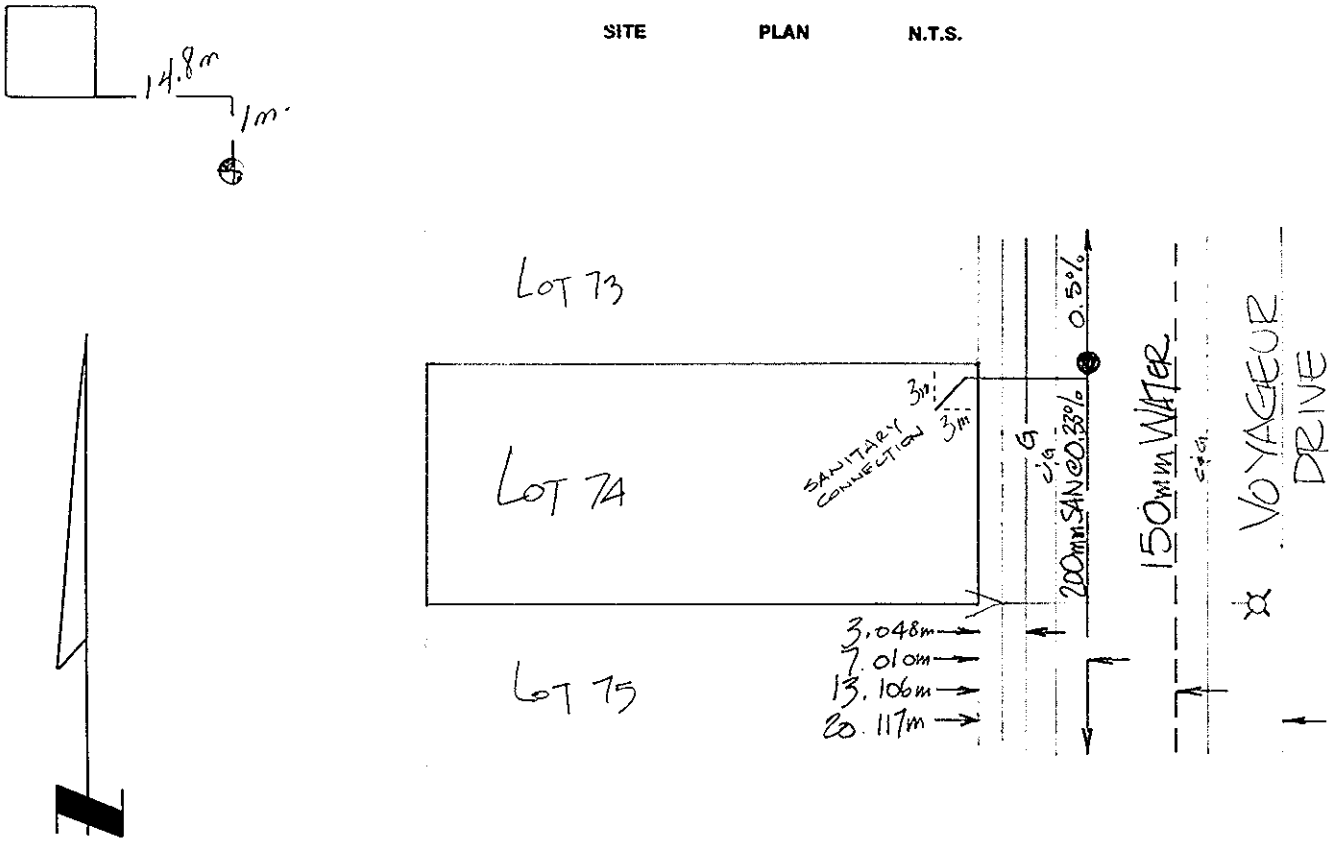
SITE PLAN N.T.S.