City of Prince George
HISTORY SHEET

SHEET NUMBER № 0581 **Roll Number** 309518605

Legal: LOT'S 23. BLOCK D.L. 2610 PLAN 21450.

Address: 311 EXPLORER CRES

Sanitary Connection: # 9022 SIZE 100mm MATERIAL A.C. INV. CONNECTED

Water Connection # SIZE 20mm MATERIAL Cu. METER CONNECTED

Storm Connection: # SIZE MATERIAL INV. CONNECTED

Cash Receipt No's: WATER SANITARY STORM

CURB FROM PROPERTY LINE 4.877m PAVEMENT WIDTH 10.363m

B.C. HYDRO UNDERGROUND UNDERGROUND CONNECTION YES

B.C. TELEPHONE UNDERGROUND UNDERGROUND CONNECTION YES

INLAND GAS As SHOWN

Information Sheets:

Comments:
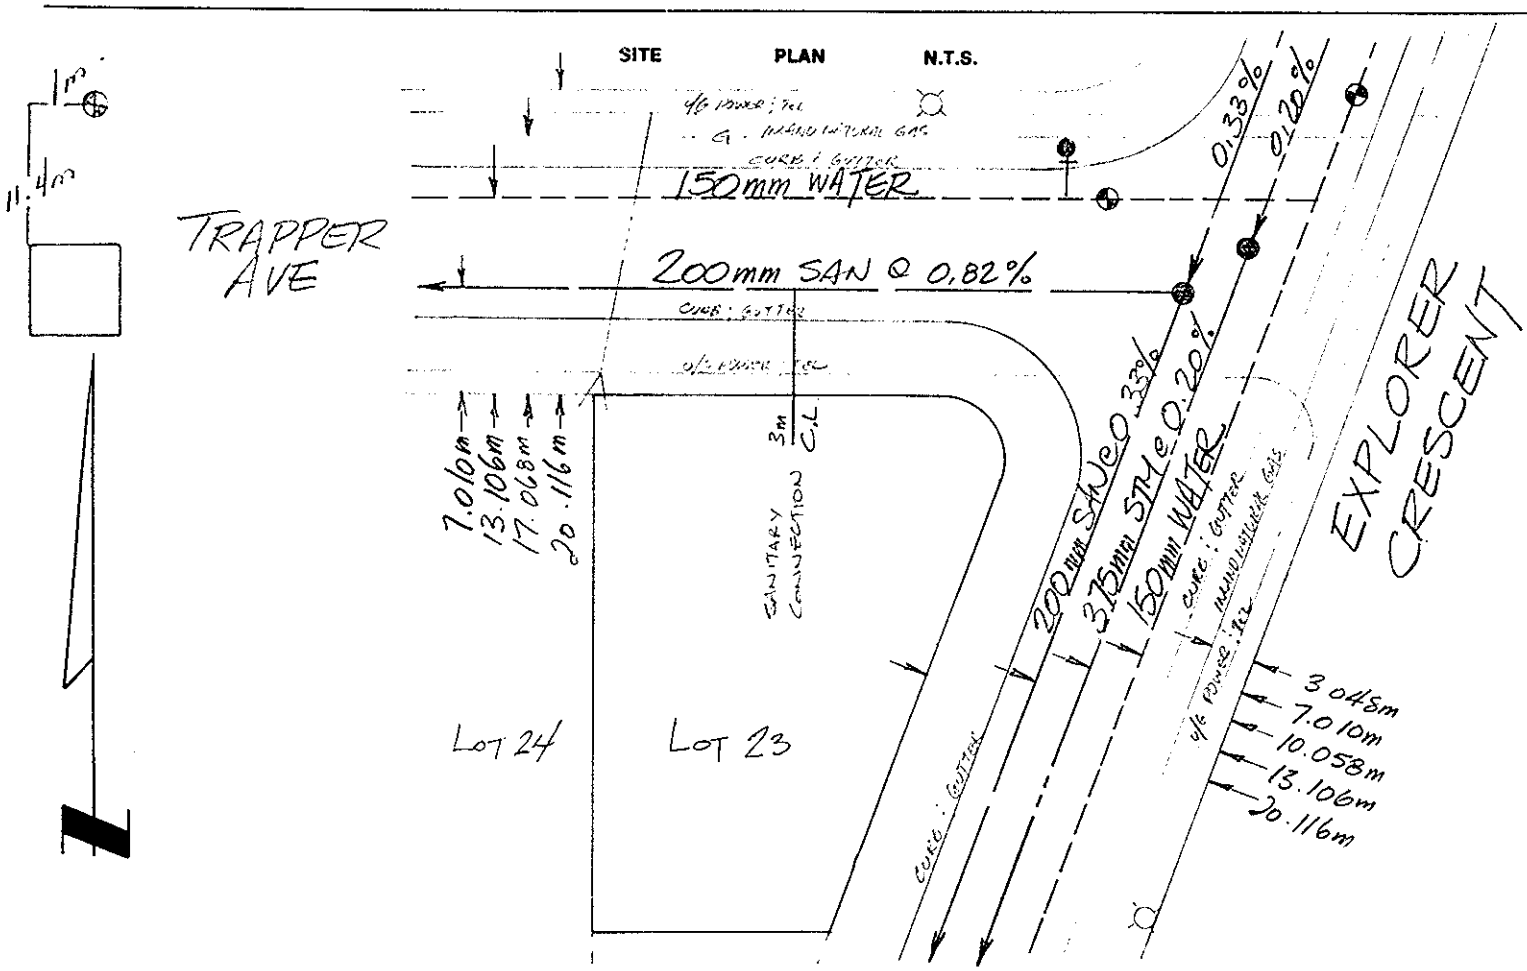
SITE PLAN N.T.S.