City of Prince George
HISTORY SHEET

0095 74328
0095 74344

SHEET NUMBER **350** **Roll Number** 1174-000

Legal: LOT'S 13-14 BLOCK 56 D.L. 343 PLAN 1268

Address: WOLSFELD EVELYN T 370 ALWARD ST. PRINCE GEORGE, BC 370 ALWARD ST.

Sanitary Connection: # 3433 SIZE - MATERIAL - INV. 1926.86 CONNECTED YES.

Water Connection # - SIZE 20mm MATERIAL Cu METER CONNECTED -

Storm Connection: # - SIZE MATERIAL INV. CONNECTED -

Cash Receipt No's: WATER SANITARY 1432 STORM

CURB FROM PROPERTY LINE 16 PAVEMENT WIDTH 34.

B.C. HYDRO O.H. UNDERGROUND CONNECTION -

B.C. TELEPHONE O.H UNDERGROUND CONNECTION -

INLAND GAS IN LANE 1½" Φ MAIN.

Information Sheets: -

Comments:
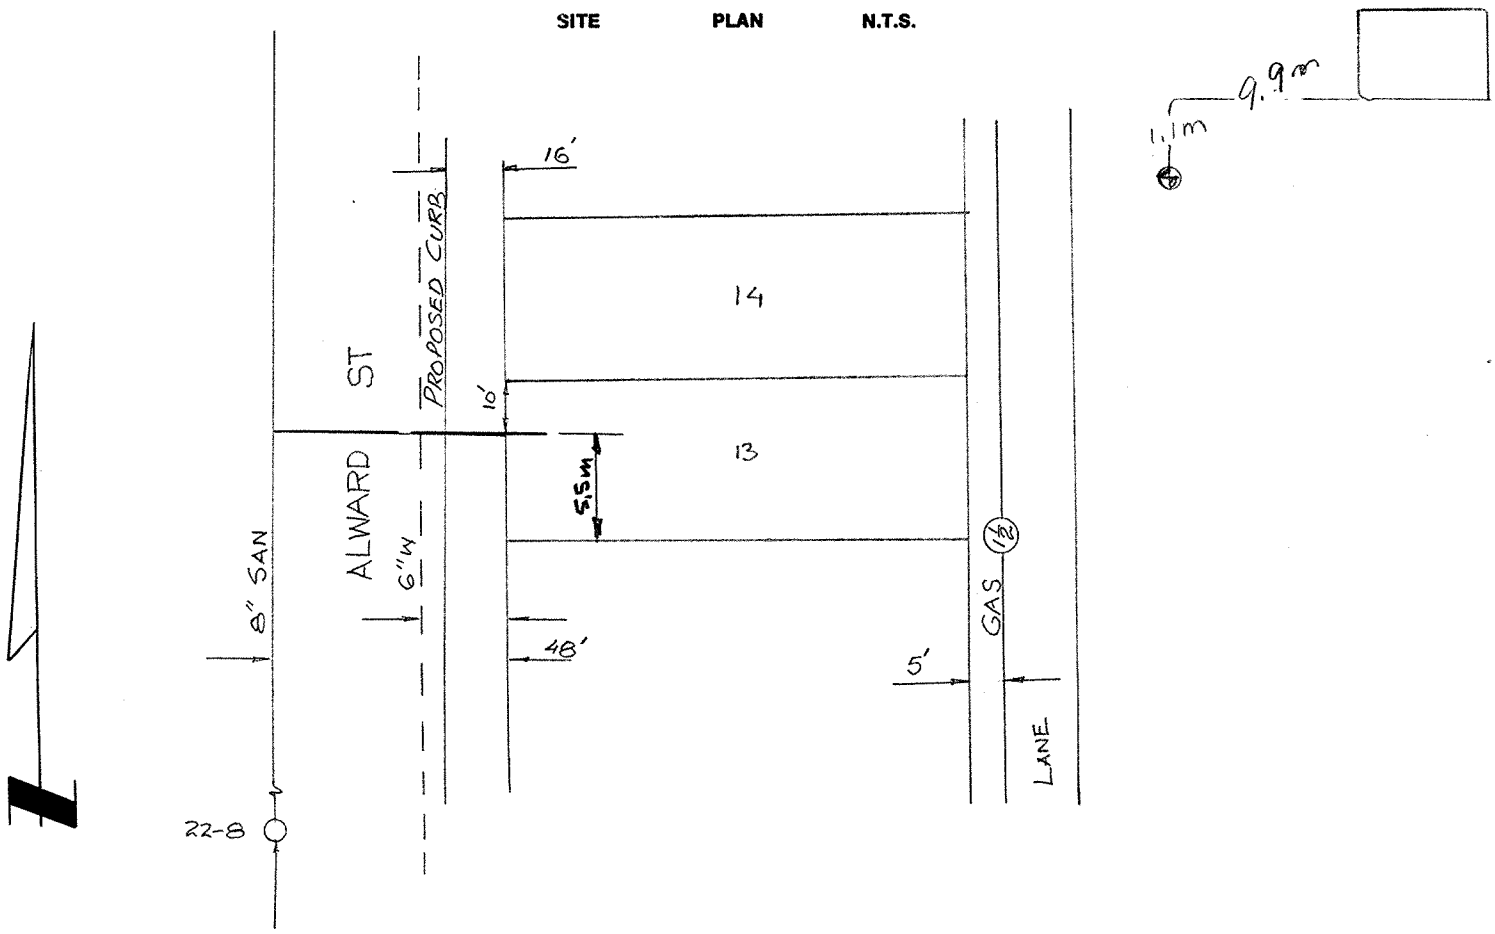
SITE PLAN N.T.S.