City of Prince George
HISTORY SHEET

CC 9646424 00964076
CC 9646442
CC 9646451

SHEET NUMBER **409**

Roll Number 1315-000

Legal: LOT'S 6-8 AMD 9 BLOCK 62 D.L. 343 PLAN 1268

Address: EL RANCHO TAKE HOME RESTAURANT LTD. 3170 15TH AVE PRINCE GEORGE, BC SEE 114211 M & PL 17372 ✓ 2060 5TH AVE. 475 WATROUS STREET

Sanitary Connection: # 254, 6657 SIZE – 100mm MATERIAL – A.C. INV. 586.489, 586.400 CONNECTED YES, –

Water Connection # 6657, 2280 SIZE 25mm MATERIAL Cu, – METER #357; – CONNECTED –, –

Storm Connection: # 294 SIZE 150mm MATERIAL – INV. 26.82 CONNECTED –

Cash Receipt No's: WATER 108; – SANITARY 928; 107 STORM

CURB FROM PROPERTY LINE – PAVEMENT WIDTH

B.C. HYDRO O.H. UNDERGROUND CONNECTION –

B.C. TELEPHONE IN 5TH AVE U/T 21 UNDERGROUND CONNECTION –

INLAND GAS IN LANE & 5TH AVE 38mm & 100mm ⌀ MAINS.

Information Sheets: 1351
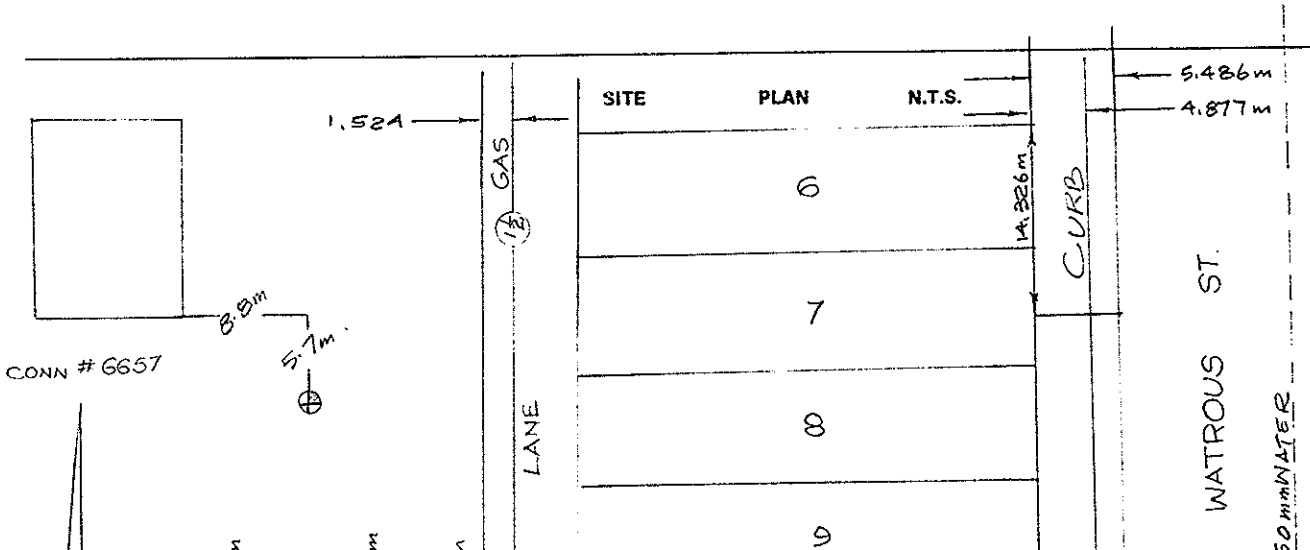
Comments: