City of Prince George
HISTORY SHEET

0096 48259
0096 48267

SHEET NUMBER **427** **Roll Number** 1352-000

Legal: LOT'S 3-4 BLOCK 64 D.L. 343 PLAN 1268

Address: BAUMAN GLEN 425 ALWARD ST
BAUMAN MARGARET E PRINCE GEORGE B.C 425 ALWARD ST.

Sanitary Connection: # — 9083 SIZE 4" MATERIAL A.C. INV. CONNECTED —

Water Connection # — SIZE MATERIAL METER CONNECTED —

Storm Connection: # — SIZE MATERIAL INV. CONNECTED —

Cash Receipt No's: WATER SANITARY 80 STORM

CURB FROM PROPERTY LINE 16' PAVEMENT WIDTH 34'

B.C. HYDRO O.H UNDERGROUND CONNECTION —

B.C. TELEPHONE O.H UNDERGROUND CONNECTION —

INLAND GAS IN LANE 2" Ø MAIN.

Information Sheets: —

Comments: REPLACED WITH P.V.C.; CLEANOUT ON ℞
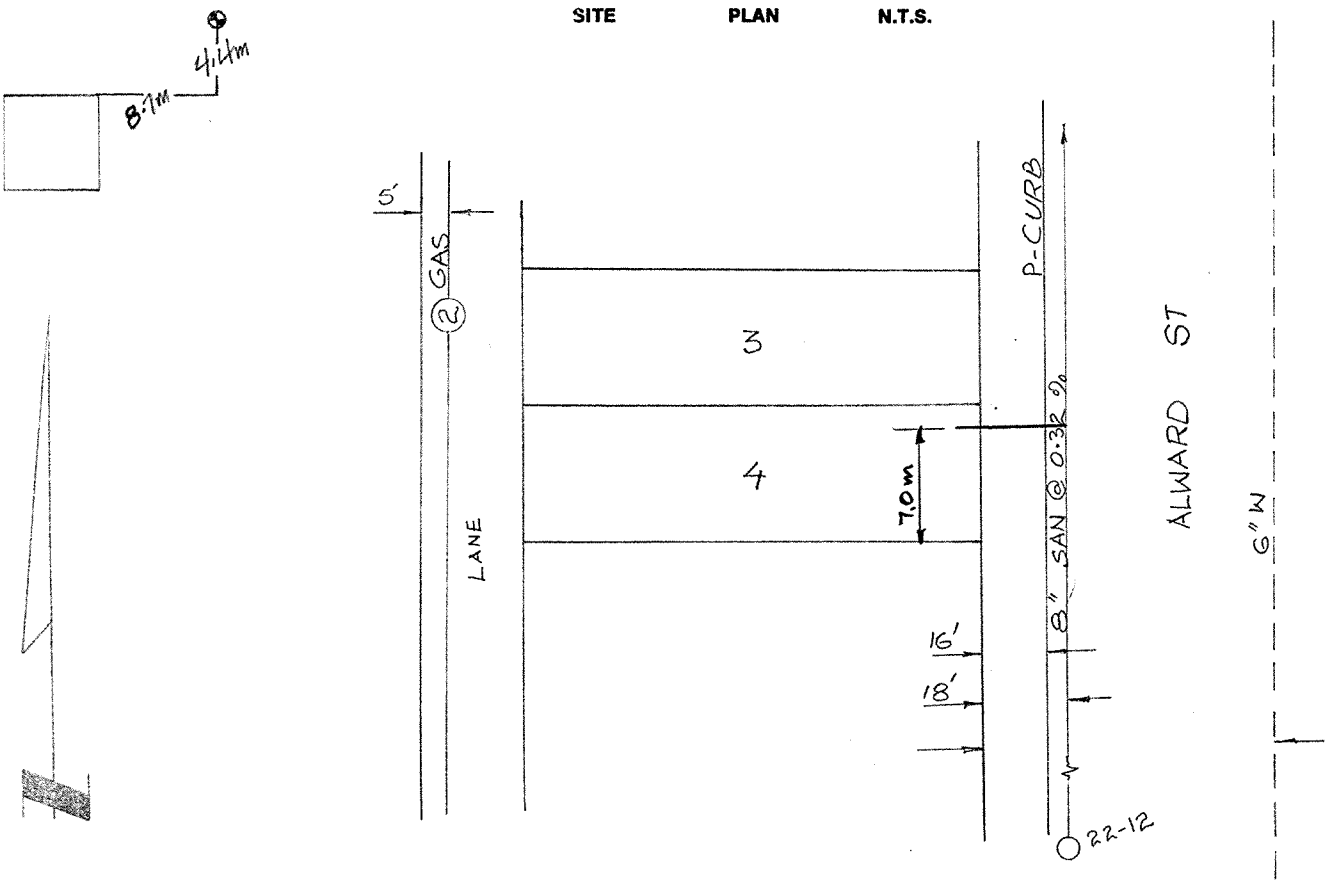
SITE PLAN N.T.S.