City of Prince George
HISTORY SHEET

SHEET NUMBER **Roll Number** 009678140

Legal: LOT'S 26 BLOCK D.L. PLAN 20917

Address: 174 McEACHERN PL

Sanitary Connection: # 10117 SIZE MATERIAL INV. CONNECTED

Water Connection # 10117 SIZE 3/4" MATERIAL Cu. METER CONNECTED

Storm Connection: # SIZE MATERIAL INV. CONNECTED

Cash Receipt No's: WATER SANITARY STORM

CURB FROM PROPERTY LINE PAVEMENT WIDTH

B.C. HYDRO UNDERGROUND CONNECTION

B.C. TELEPHONE UNDERGROUND CONNECTION

INLAND GAS

Information Sheets:

Comments:
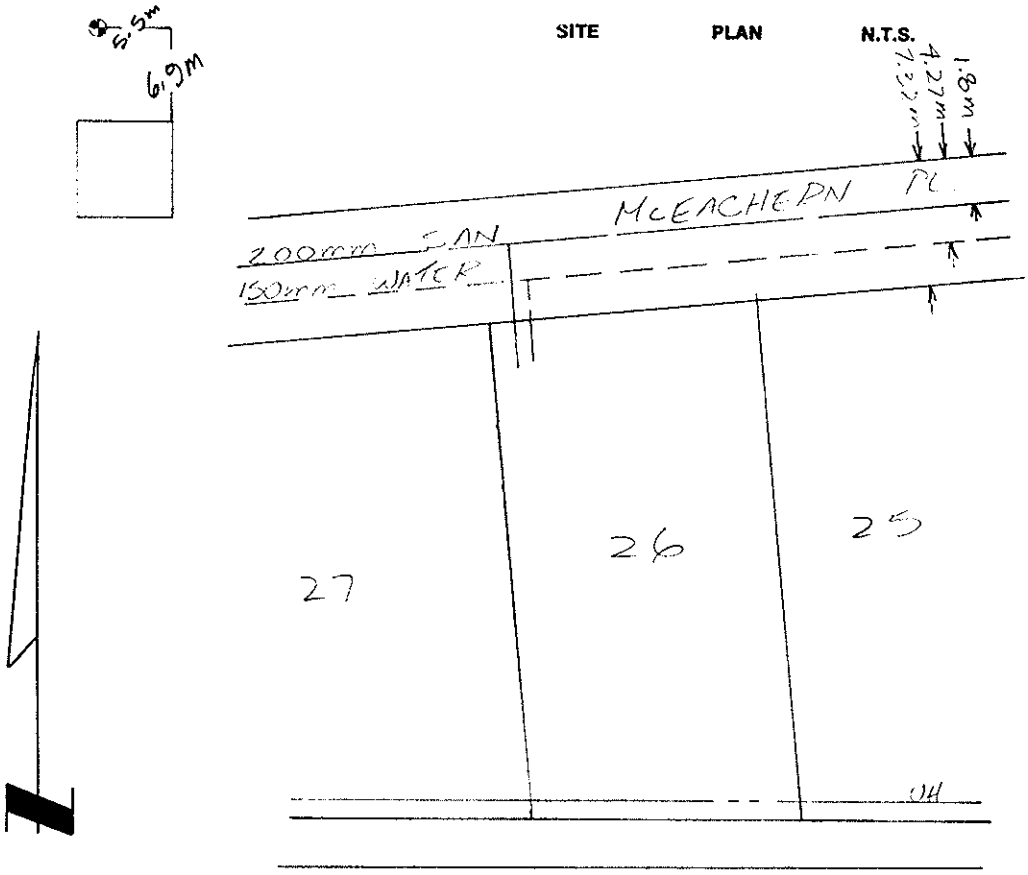
SITE PLAN N.T.S.