City of Prince George
HISTORY SHEET

009688471
009688510

SHEET NUMBER **476** **Roll Number** 1455-000

Legal: LOT'S 5-6 BLOCK 69 D.L. 343 PLAN 1268

Address: BERTSCHI ALBERT SHELLY B.C. BERTSCHI CHARLES. 551 WATROUS ST.

Sanitary Connection: # 3083 SIZE – MATERIAL – INV. 1925.39 CONNECTED YES.

Water Connection # 89 SIZE ½" MATERIAL – METER – CONNECTED –

Storm Connection: # SIZE MATERIAL INV. CONNECTED –

Cash Receipt No's: WATER – SANITARY 751 STORM

CURB FROM PROPERTY LINE – PAVEMENT WIDTH –

B.C. HYDRO O·H UNDERGROUND CONNECTION –

B.C. TELEPHONE O·H UNDERGROUND CONNECTION –

INLAND GAS IN LANE 1½" ⊕ MAIN.

Information Sheets: –

Comments:
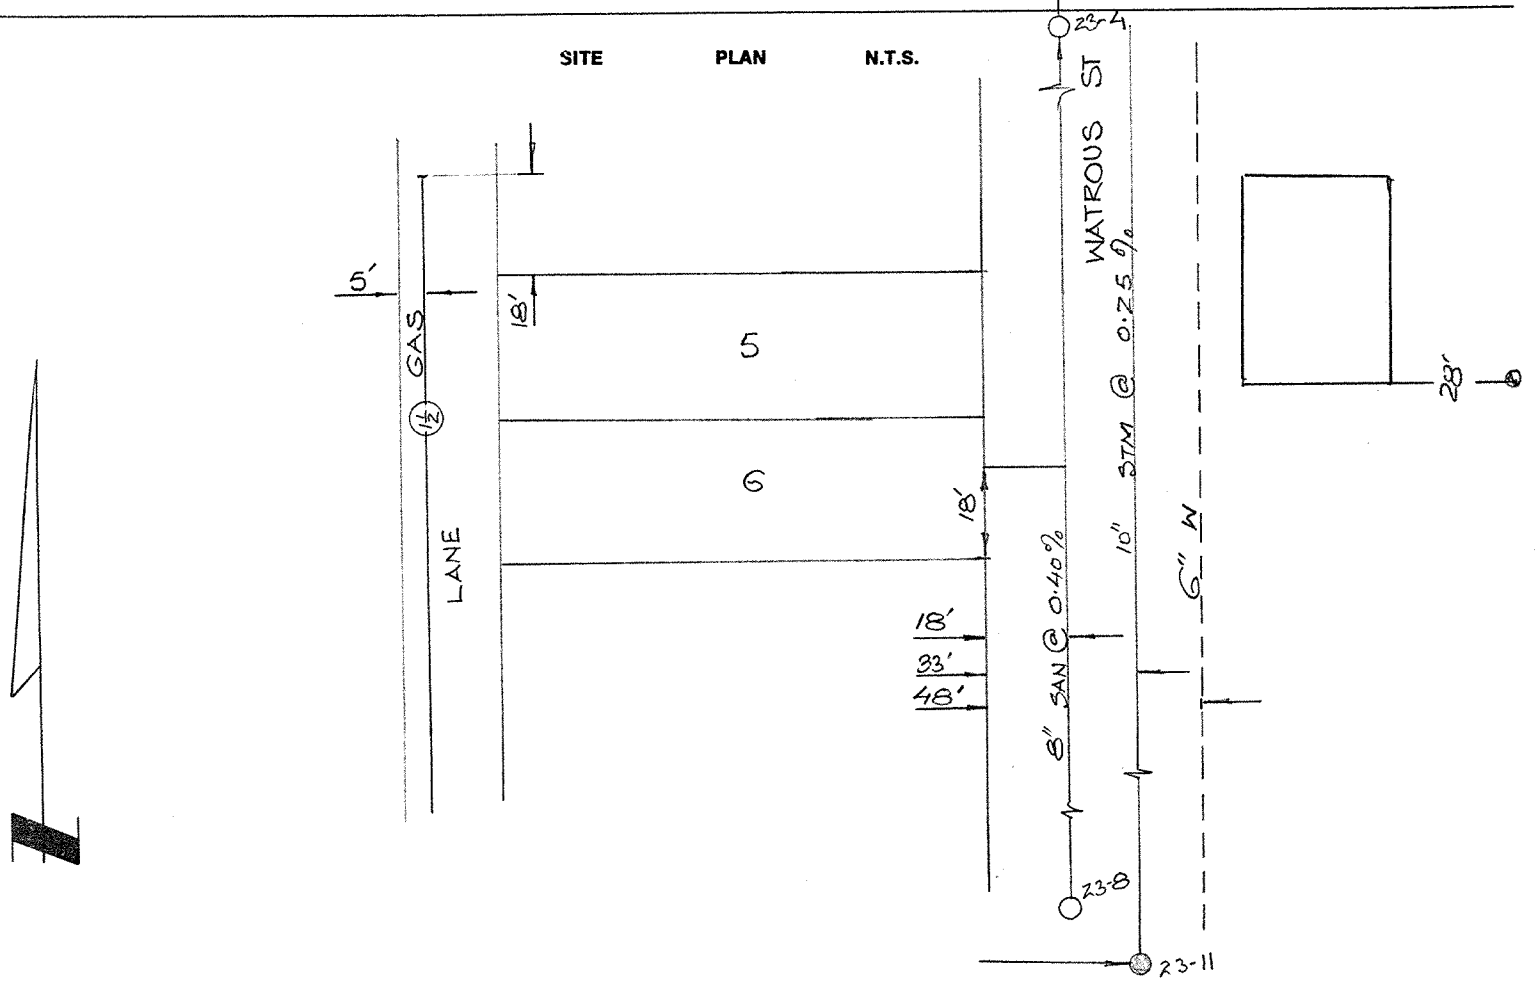
SITE PLAN N.T.S.