City of Prince George
HISTORY SHEET

FL

SHEET NUMBER **Roll Number** 00971691 2

Legal: LOT'S 41 BLOCK — D.L. 2507 PLAN 20916

Address: 974 OCHAKWIN CRES

Sanitary Connection: # 8836 SIZE 100 mm MATERIAL A.C. INV. CONNECTED

Water Connection # 8836 SIZE 20 mm MATERIAL COPPER METER CONNECTED

Storm Connection: # SIZE MATERIAL INV. CONNECTED

Cash Receipt No's: WATER SANITARY STORM

CURB FROM PROPERTY LINE 4.877 m PAVEMENT WIDTH 10.363 m

B.C. HYDRO U/G UNDERGROUND CONNECTION

B.C. TELEPHONE U/G UNDERGROUND CONNECTION

INLAND GAS 3.048 m FROM PL.

Information Sheets:

Comments: WITH THAW WIRE.
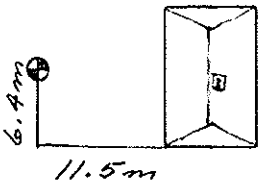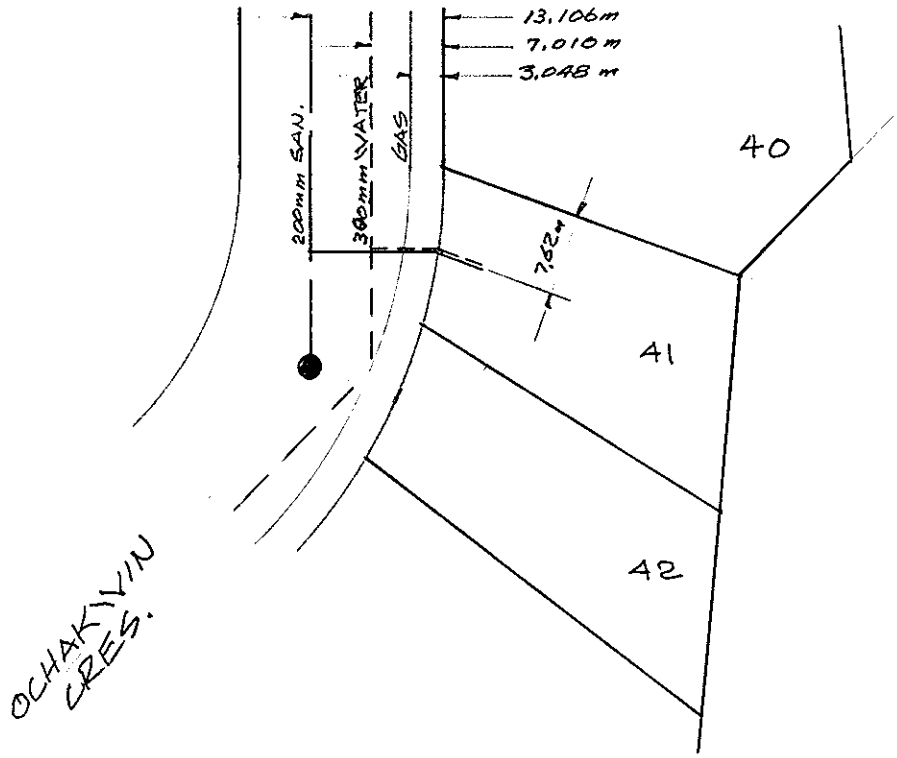
THE INFORMATION CONTAINED HEREIN IS FOR INTERNAL USE ONLY.
NOT TO BE RELIED UPON UNLESS CONFIRMED BY SITE INSPECTION AND/OR INVESTIGATION