City of Prince George
HISTORY SHEET

SHEET NUMBER | **Roll Number** 309984090

Legal: LOT'S 86 BLOCK D.L. 2507 PLAN 20829

Address: 4252 PUNCHAW CRES.

Sanitary Connection: # 8412 SIZE 100mm MATERIAL A.C. INV. CONNECTED

Water Connection # 8412 SIZE 20mm MATERIAL CU. METER CONNECTED

Storm Connection: # SIZE MATERIAL INV. CONNECTED

Cash Receipt No's: WATER SANITARY STORM

CURB FROM PROPERTY LINE 4.877m PAVEMENT WIDTH 10.363m

B.C. HYDRO U/G UNDERGROUND CONNECTION

B.C. TELEPHONE U/G UNDERGROUND CONNECTION

INLAND GAS AS SHOWN

Information Sheets:

Comments:
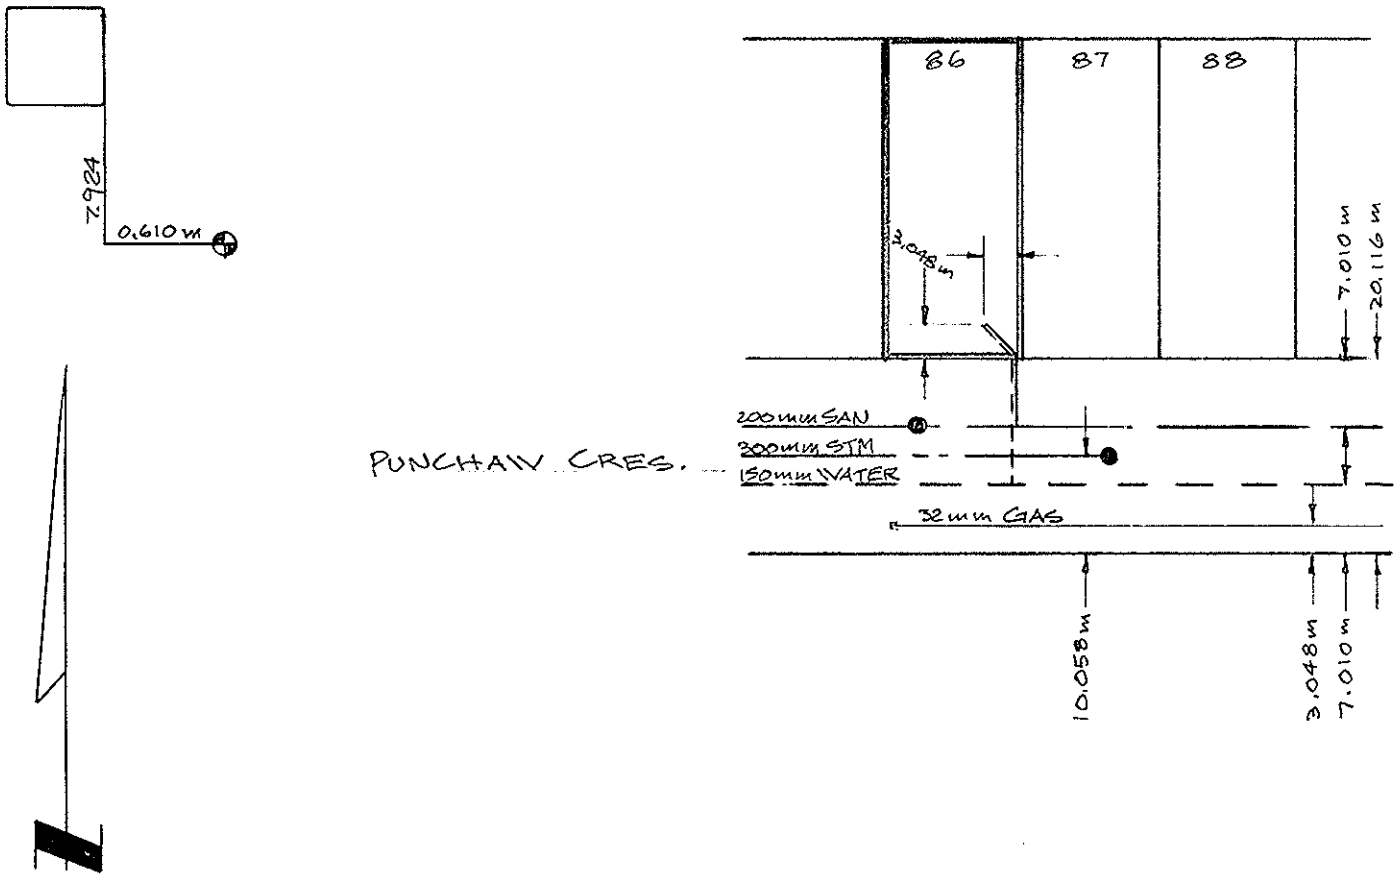
THE INFORMATION CONTAINED HEREIN IS FOR INTERNAL USE ONLY.
NOT TO BE RELIED UPON UNLESS CONFIRMED BY SITE INSPECTION AND/OR INVESTIGATION