City of Prince George
HISTORY SHEET

1) 5

SHEET NUMBER **Roll Number** 009785086

Legal: LOT'S 93 BLOCK D.L. 2610 PLAN 20829

Address: 4202 PUNCHAW CRES.

Sanitary Connection: # 8419 SIZE 100 mm MATERIAL A.C. INV. CONNECTED

Water Connection # 8419 SIZE 20 mm MATERIAL CU. METER CONNECTED

Storm Connection: # SIZE MATERIAL INV. CONNECTED

Cash Receipt No's: WATER SANITARY STORM

CURB FROM PROPERTY LINE 4.877 m PAVEMENT WIDTH 10.363 m

B.C. HYDRO U/G UNDERGROUND CONNECTION

B.C. TELEPHONE U/G UNDERGROUND CONNECTION

INLAND GAS AS SHOWN

Information Sheets:

Comments:
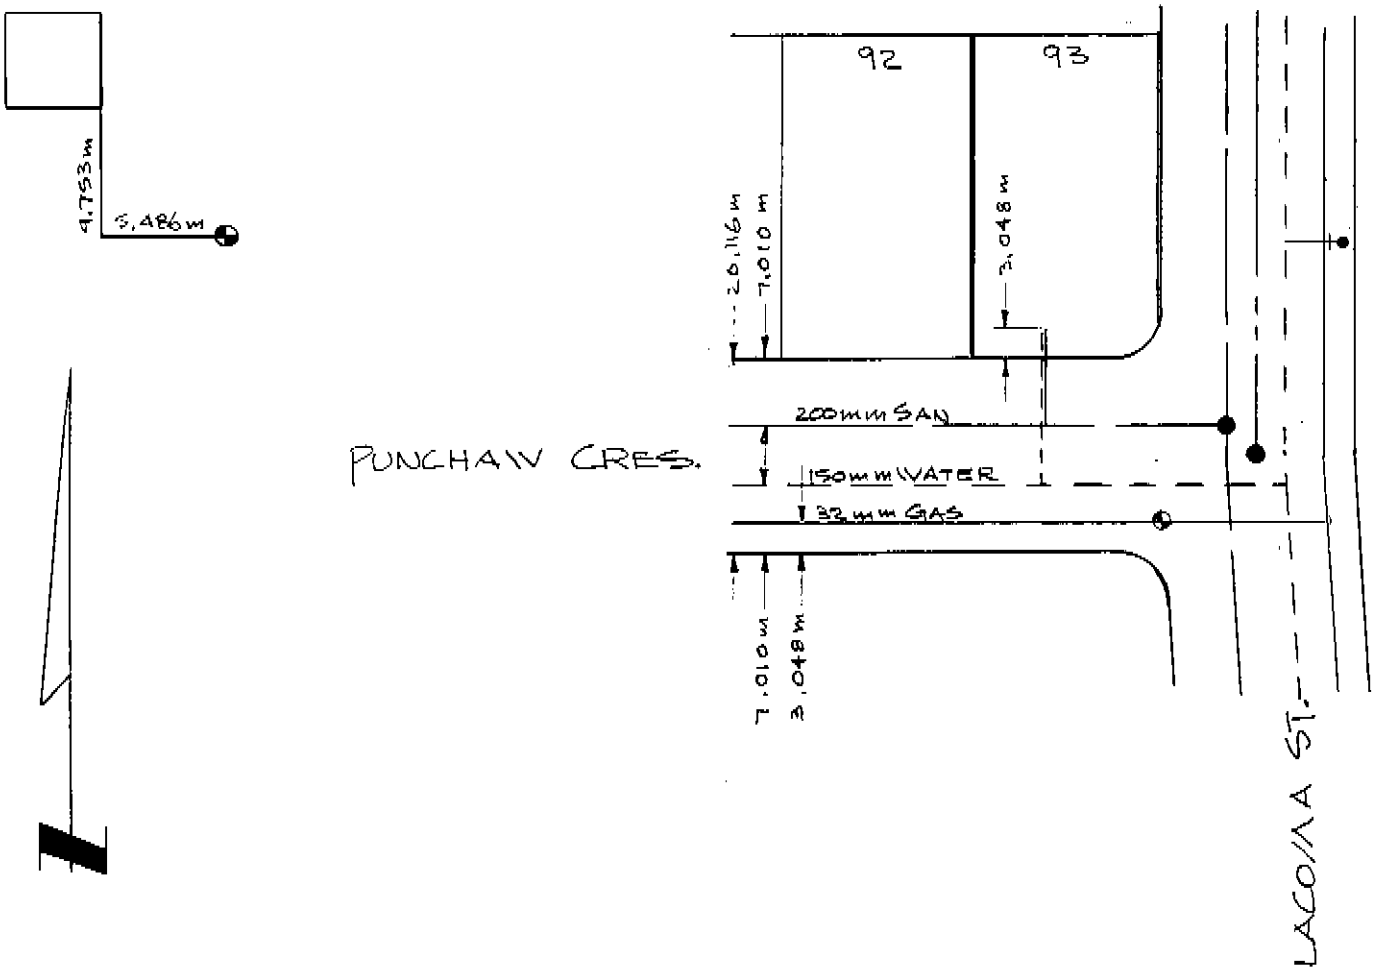
THE INFORMATION CONTAINED HEREIN IS FOR INTERNAL USE ONLY.
NOT TO BE RELIED UPON UNLESS CONFIRMED BY SITE INSPECTION AND/OR INVESTIGATION