City of Prince George
HISTORY SHEET

SHEET NUMBER 1398 **Roll Number**

Legal: LOT'S 16 - 17 BLOCK 162 D.L. 343 PLAN 1268

Address: 1460 6th AVENUE

Sanitary Connection: # 7769 SIZE 4" MATERIAL A.C. INV. 76.73 CONNECTED YES

Water Connection # 7786 SIZE 1" MATERIAL COPPER METER - CONNECTED YES

Storm Connection: # — SIZE — MATERIAL — INV. — CONNECTED —

Cash Receipt No's: WATER SANITARY STORM

CURB FROM PROPERTY LINE 10' PAVEMENT WIDTH 46'

B.C. HYDRO O. H. UNDERGROUND CONNECTION

B.C. TELEPHONE UNDERGROUND CONNECTION IN 6th AVE. 6'-5" FROM P/L

INLAND GAS IN LANE @ 2" MAIN

Information Sheets:

Comments: BENCH MARK # 12-68 ELEVATION = 1888.89

S.I.P. S.E. CORNER 6th AND VICTORIA

LEVEL BOOK # 281
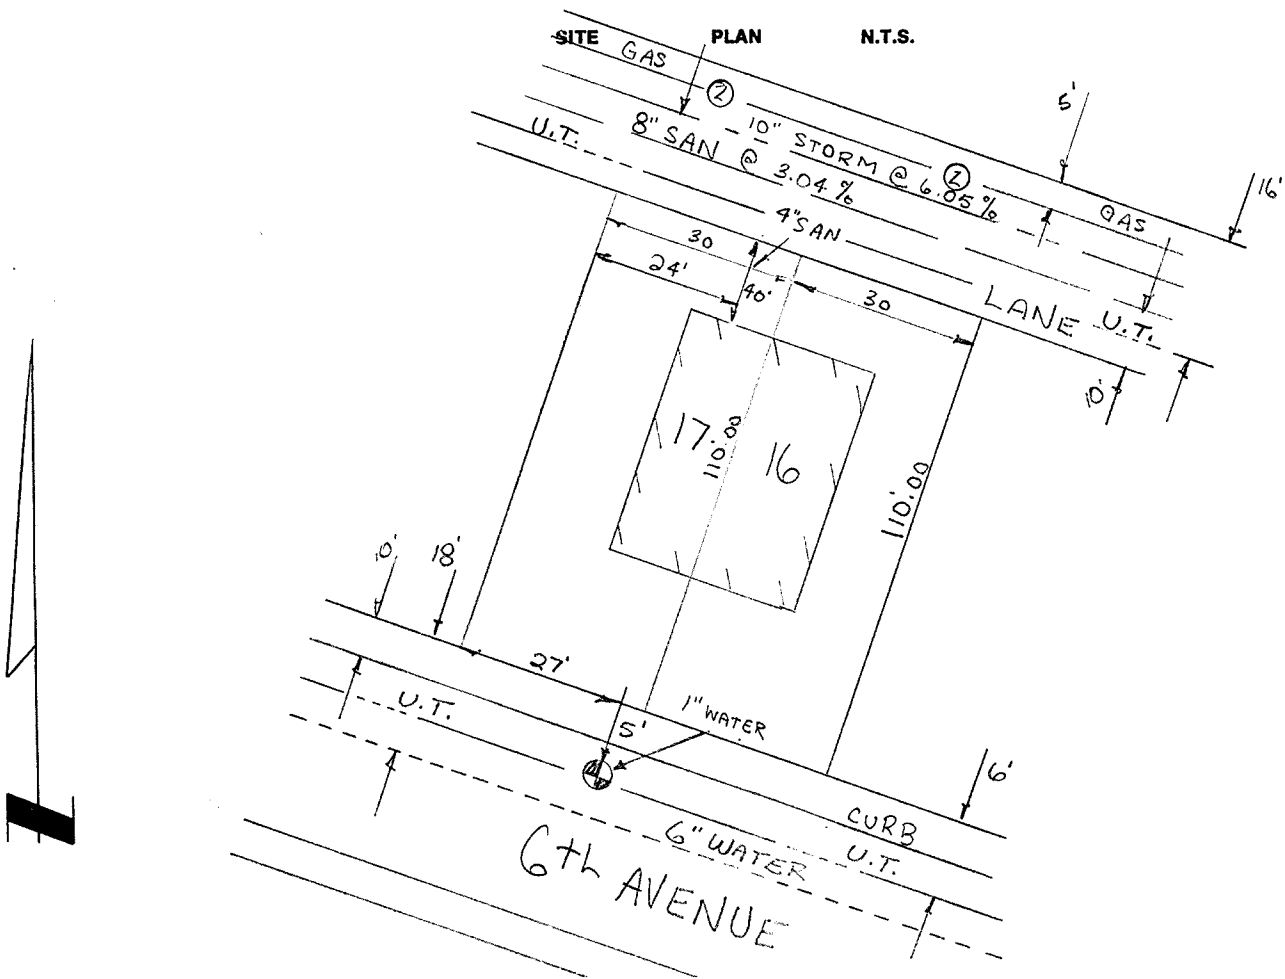
SITE PLAN N.T.S.