City of Prince George
HISTORY SHEET

SHEET NUMBER 7069 **Roll Number** 009891471

Legal: LOT'S 10 BLOCK D.L. 4048 PLAN 20605

Address: 6664 EDELWEISS

Sanitary Connection: # 15584 SIZE 100mm MATERIAL INV. CONNECTED

Water Connection # SIZE 3/4" MATERIAL Cu METER CONNECTED

Storm Connection: # SIZE MATERIAL INV. CONNECTED

Cash Receipt No's: WATER SANITARY STORM

CURB FROM PROPERTY LINE PAVEMENT WIDTH

B.C. HYDRO UNDERGROUND CONNECTION

B.C. TELEPHONE UNDERGROUND CONNECTION

INLAND GAS

Information Sheets:

Comments: NO WATER SERVICE - ON NORTH CORNER
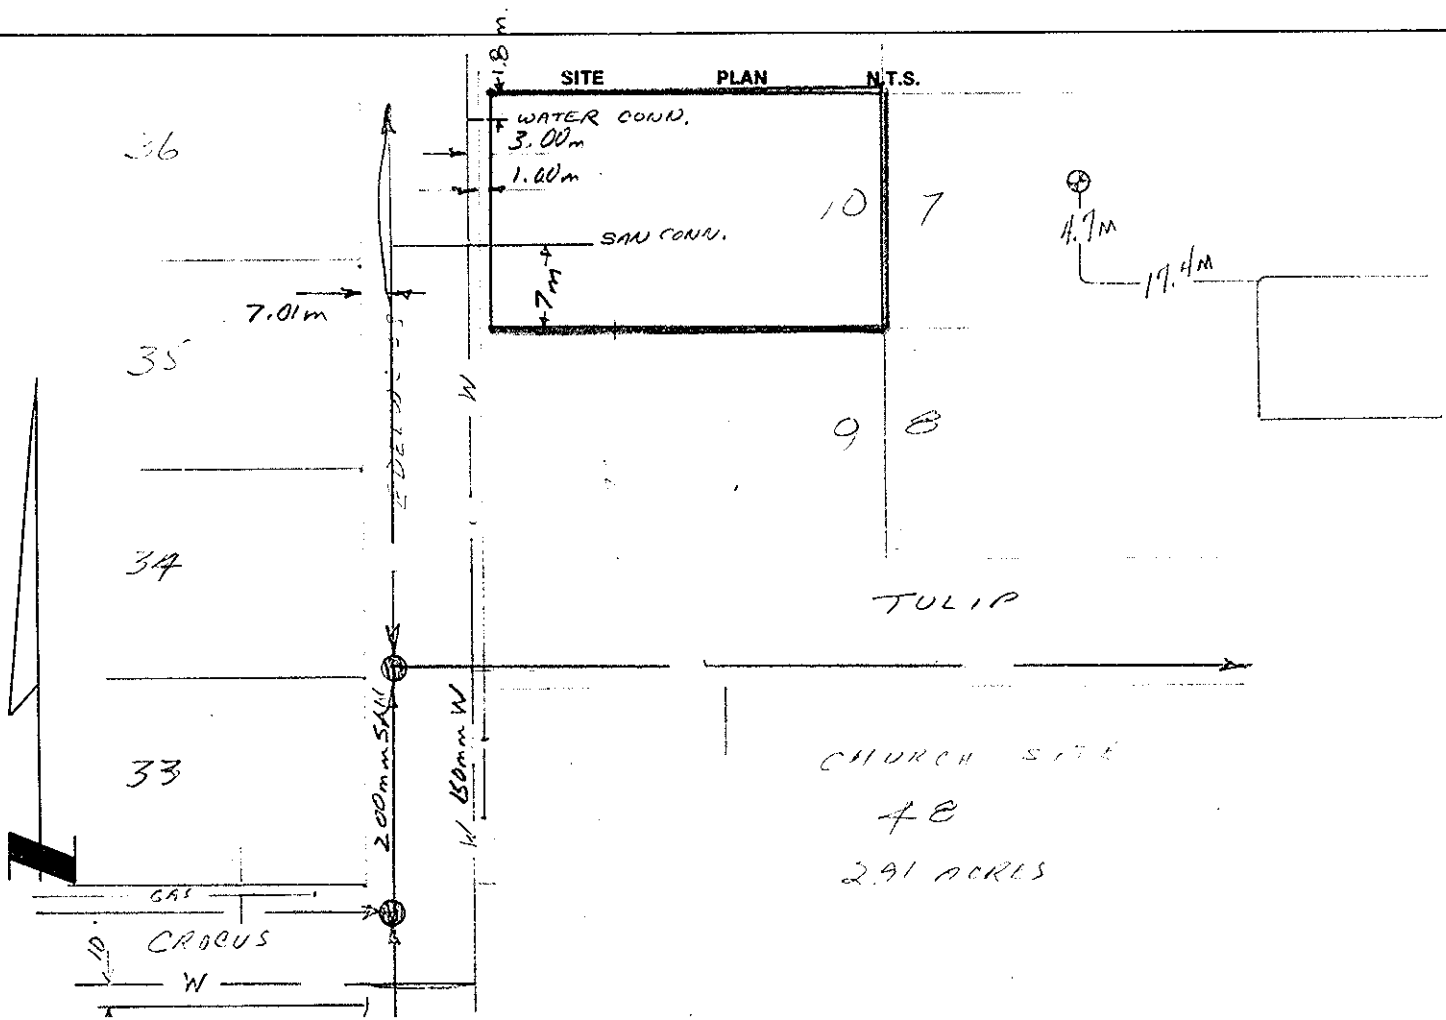
OWNER: FUSON DANIEL LEO