City of Prince George
HISTORY SHEET

5

SHEET NUMBER 6298 **Roll Number**

Legal: LOT'S 47 BLOCK D.L. 4046 PLAN 20612

Address: 3051 KILLARNEY DR.

Sanitary Connection: # SIZE MATERIAL INV. CONNECTED

Water Connection # SIZE 3/4" MATERIAL Copper METER CONNECTED

Storm Connection: # SIZE MATERIAL INV. CONNECTED

Cash Receipt No's: WATER SANITARY STORM

CURB FROM PROPERTY LINE PAVEMENT WIDTH

B.C. HYDRO UNDERGROUND CONNECTION

B.C. TELEPHONE UNDERGROUND CONNECTION

INLAND GAS

Information Sheets:

Comments: NO WATER SERVICE - ON SOUTH CORNER
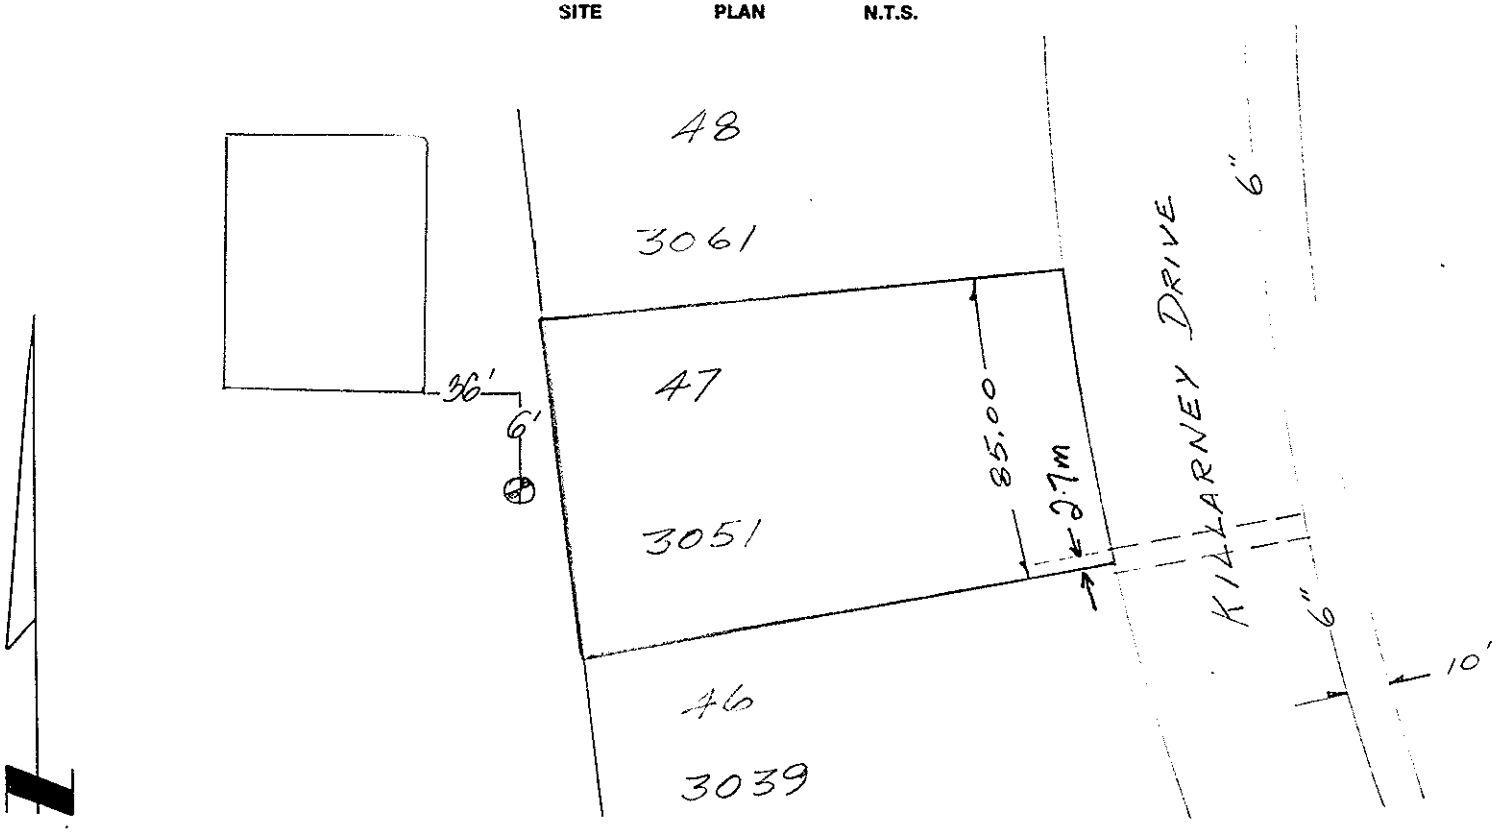
SITE PLAN N.T.S.