City of Prince George
HISTORY SHEET

FU

SHEET NUMBER 7012 **Roll Number** 009 888 365

Legal: LOT'S 21 BLOCK D.L. 4048 PLAN 20604

Address: 6861 LILAC CRESCENT

Sanitary Connection: # 15566 SIZE 100mm MATERIAL INV. CONNECTED

Water Connection # SIZE 3/4" MATERIAL COPPER METER CONNECTED

Storm Connection: # SIZE MATERIAL INV. CONNECTED

Cash Receipt No's: WATER SANITARY STORM

CURB FROM PROPERTY LINE PAVEMENT WIDTH

B.C. HYDRO UNDERGROUND CONNECTION

B.C. TELEPHONE UNDERGROUND CONNECTION

INLAND GAS

Information Sheets:

Comments: NID WATER SERVICE - ON SOUTH CORNER

OWNER LISTON EARLE WILLARD
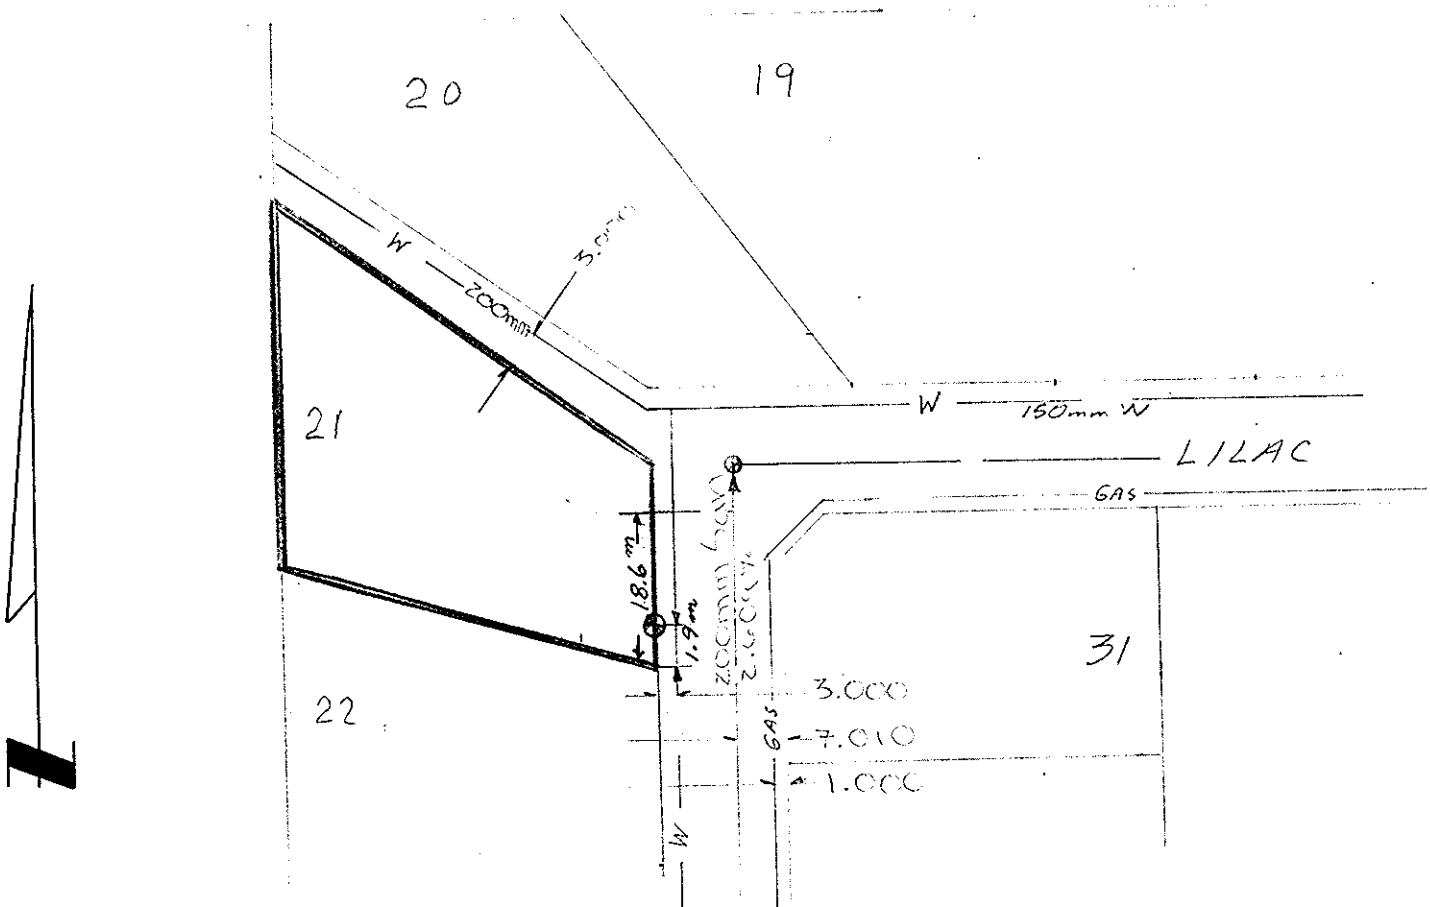
SITE PLAN N.T.S.