City of Prince George
HISTORY SHEET

5

SHEET NUMBER

Roll Number 01001072

Legal: LOT'S 54 BLOCK D.L. 8177 PLAN 20375

Address: 2990 NICOLE AVE.

Sanitary Connection: # 8296 SIZE 100mm MATERIAL AC INV. CONNECTED

Water Connection # 8296 SIZE 20mm. MATERIAL CU METER CONNECTED

Storm Connection: # SIZE MATERIAL INV. CONNECTED

Cash Receipt No's: WATER SANITARY STORM

CURB FROM PROPERTY LINE 4.877m. PAVEMENT WIDTH 10.363m.

B.C. HYDRO U/G UNDERGROUND CONNECTION YES

B.C. TELEPHONE U/G UNDERGROUND CONNECTION YES

INLAND GAS As Shown.

Information Sheets:

Comments:
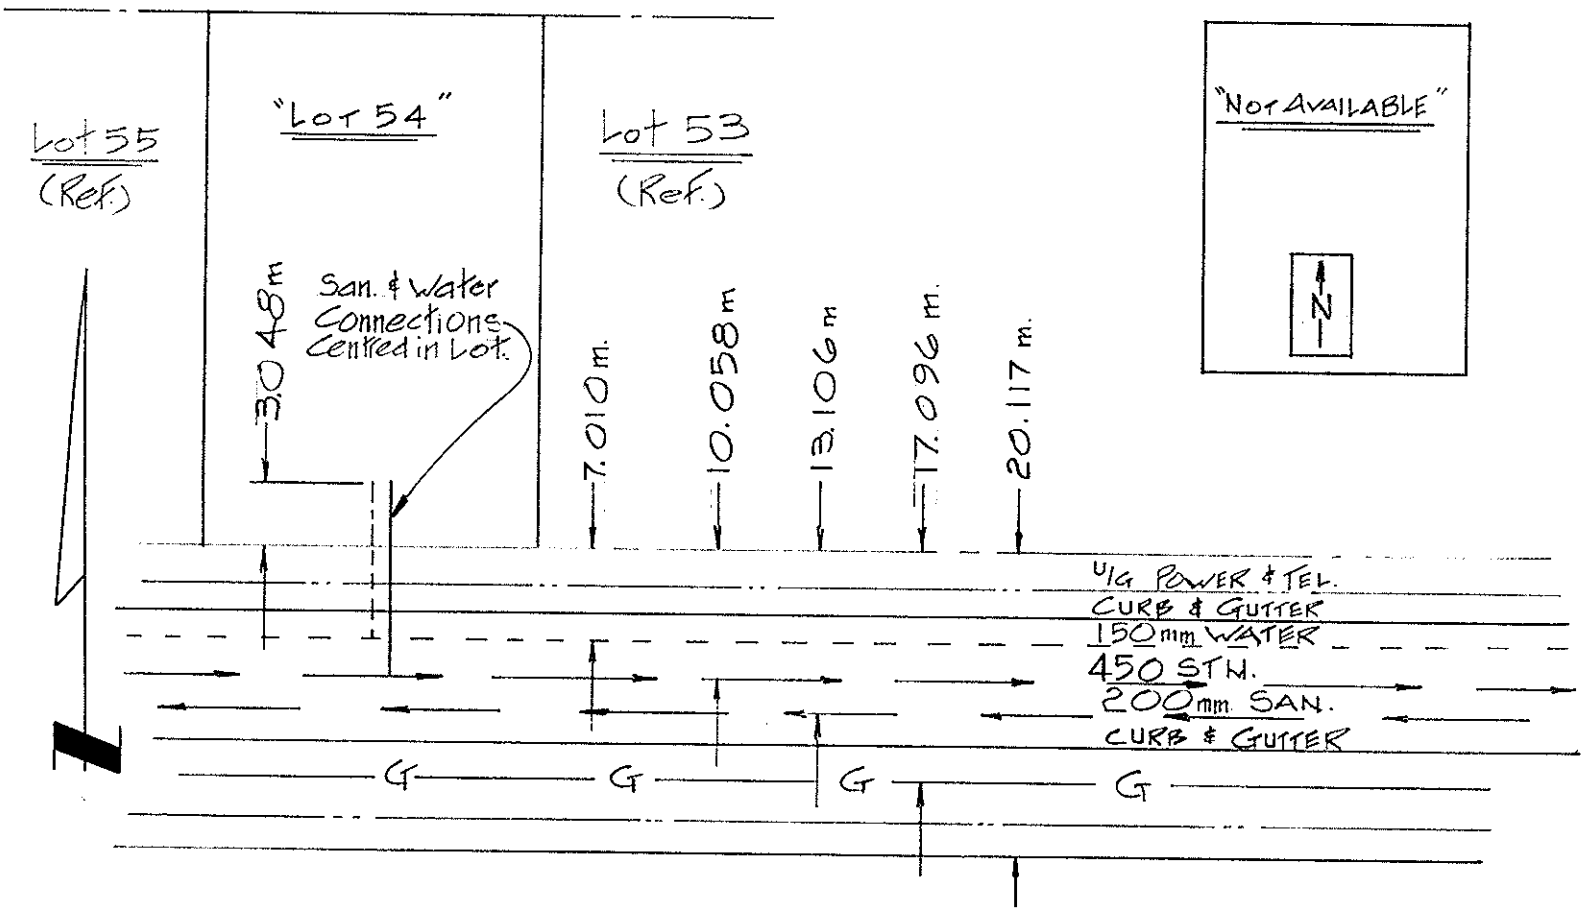
THE INFORMATION CONTAINED HEREIN IS FOR INTERNAL USE ONLY.
NOT TO BE RELIED UPON UNLESS CONFIRMED BY SITE INSPECTION AND/OR INVESTIGATION