City of Prince George
HISTORY SHEET

010317704

SHEET NUMBER **Roll Number**

Legal: LOT'S B BLOCK D.L. 932 PLAN 20368

Address: 2045 PINE STREET

Sanitary Connection: # 6658 SIZE 100 mm MATERIAL A.C. INV. 599.315 CONNECTED

Water Connection # 6712 SIZE 20mm MATERIAL CU. METER CONNECTED

Storm Connection: # SIZE MATERIAL INV. CONNECTED

Cash Receipt No's: WATER SANITARY STORM

CURB FROM PROPERTY LINE 5.791 m PAVEMENT WIDTH 12.801 m

B.C. HYDRO O/H UNDERGROUND CONNECTION

B.C. TELEPHONE O/H UNDERGROUND CONNECTION

INLAND GAS 4.572 m FROM EAST SIDE OF PINE.

Information Sheets:

Comments: WITH THAW WIRE.
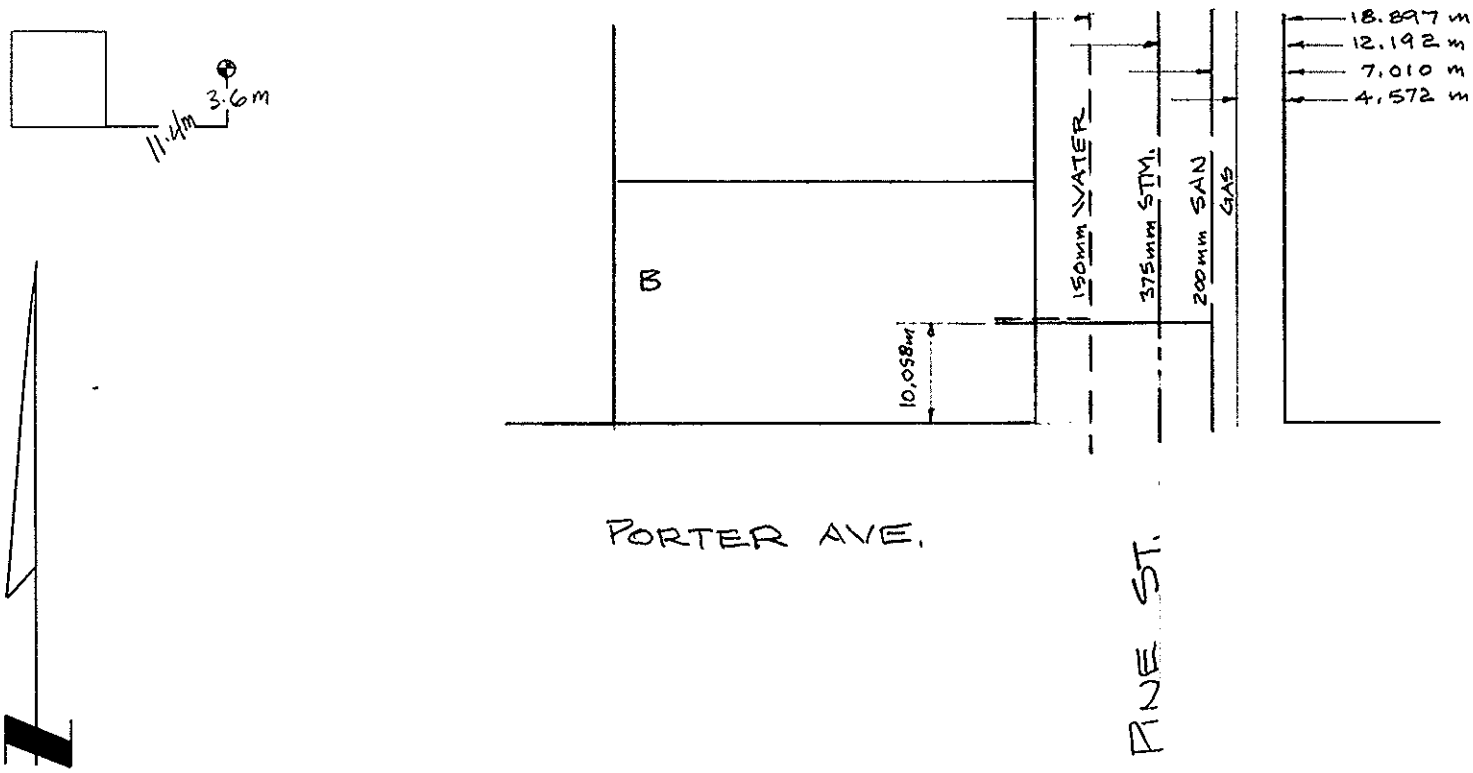
SITE PLAN N.T.S.