City of Prince George
HISTORY SHEET

SHEET NUMBER № 2549 **Roll Number** 010127381

Legal: LOT'S 102 BLOCK D.L. 754 PLAN 20248

Address: 6062 CALEDONIA CRES.

Sanitary Connection: # SIZE 100mm MATERIAL INV. CONNECTED

Water Connection # SIZE 19mm MATERIAL Cu METER CONNECTED

Storm Connection: # SIZE MATERIAL INV. CONNECTED

Cash Receipt No's: WATER SANITARY STORM

CURB FROM PROPERTY LINE PAVEMENT WIDTH

B.C. HYDRO UGP-213 UNDERGROUND CONNECTION

B.C. TELEPHONE UG UNDERGROUND CONNECTION

INLAND GAS AS SHOWN

Information Sheets:
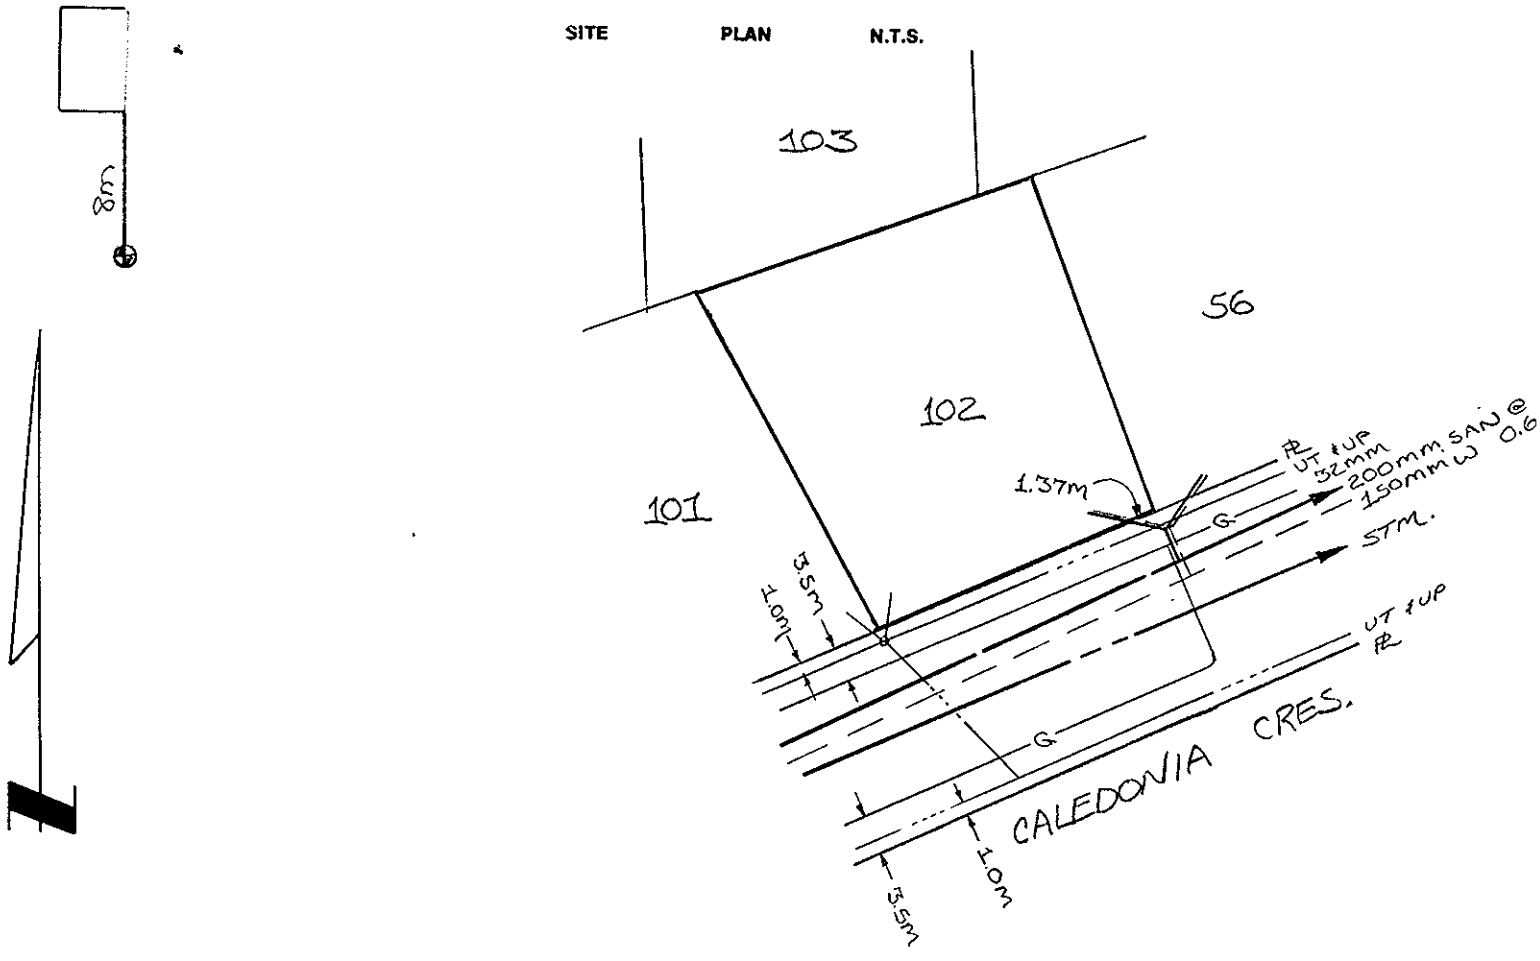
Comments: