City of Prince George
HISTORY SHEET

SHEET NUMBER **Roll Number** 010 28 [illegible]

Legal: LOT'S 2 BLOCK D.L. 2307 PLAN 20258

Address: 1233 GENEVIEVE CRES.

Sanitary Connection: # 7880 SIZE 100mm MATERIAL INV. CONNECTED

Water Connection # 7880 SIZE 20mm MATERIAL Cu. METER CONNECTED

Storm Connection: # SIZE MATERIAL INV. CONNECTED

Cash Receipt No's: WATER SANITARY STORM

CURB FROM PROPERTY LINE PAVEMENT WIDTH

B.C. HYDRO UNDERGROUND CONNECTION

B.C. TELEPHONE UNDERGROUND CONNECTION

INLAND GAS

Information Sheets:

Comments:
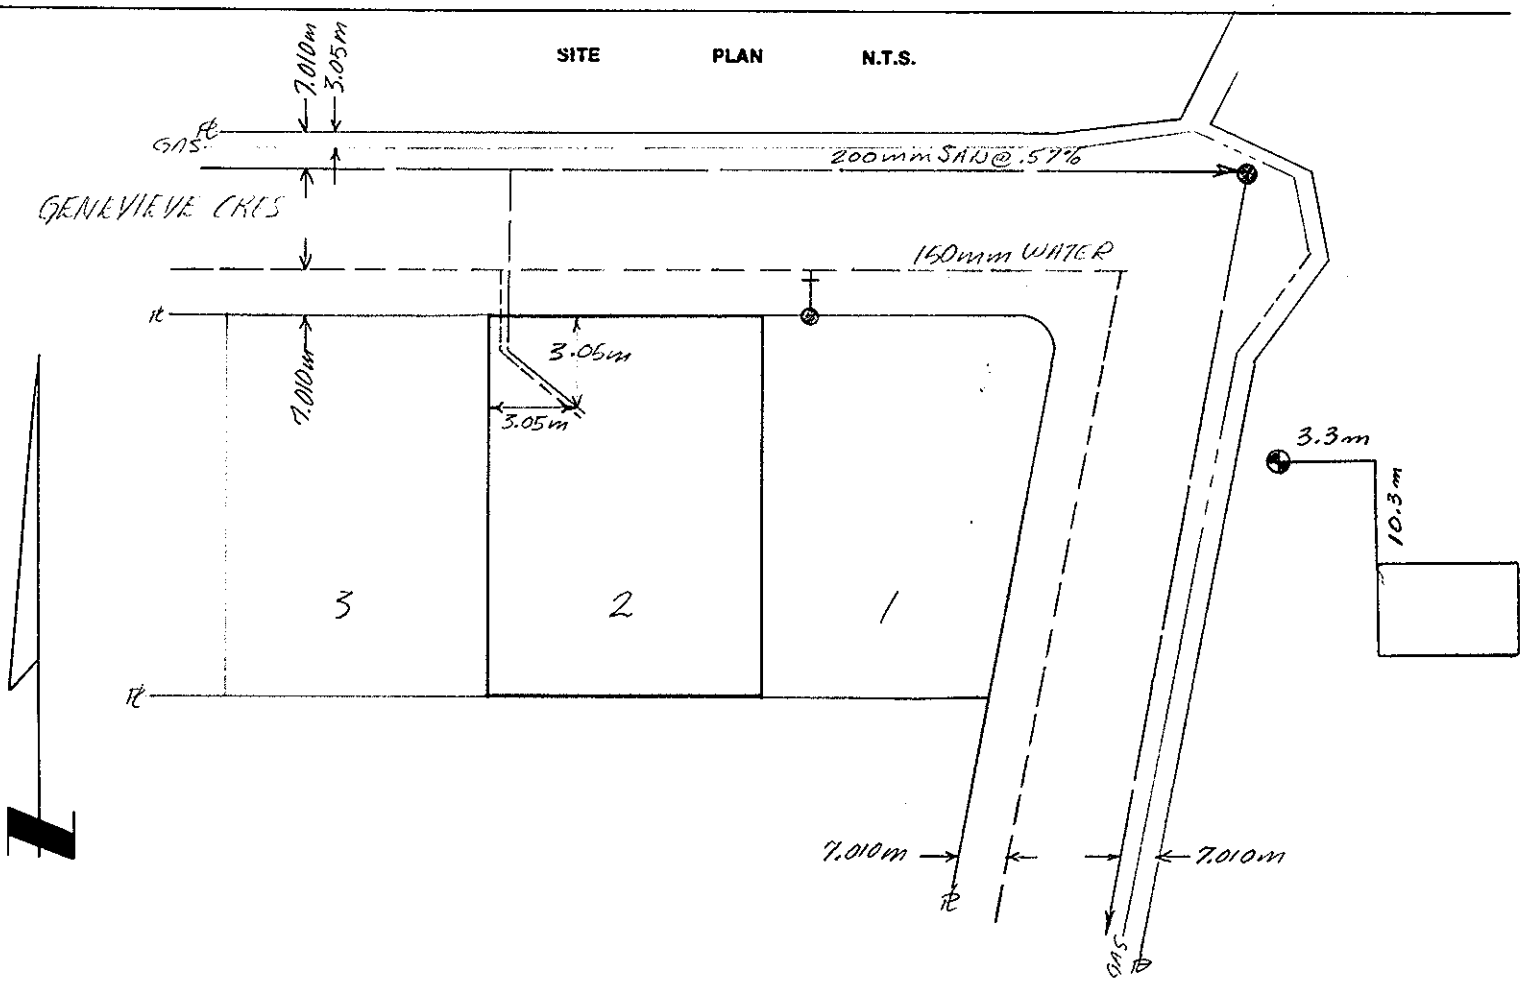
SITE PLAN N.T.S.