0101[illegible]
011790012
0101912[illegible]

City of Prince George
HISTORY SHEET

D S

SHEET NUMBER № 2232 Roll Number

Legal: LOT'S B, 1, 2 BLOCK 332 D.L. 343 PLAN 1268

Address: 1911 SPRUCE ST.

Sanitary Connection: # 1932 SIZE MATERIAL INV. CONNECTED

Water Connection # 3034 SIZE 3/4" MATERIAL COPPER METER CONNECTED

Storm Connection: # SIZE MATERIAL INV. CONNECTED

Cash Receipt No's: WATER SANITARY STORM

CURB FROM PROPERTY LINE PAVEMENT WIDTH

B.C. HYDRO UNDERGROUND CONNECTION

B.C. TELEPHONE UNDERGROUND CONNECTION

INLAND GAS

Information Sheets:

Comments:
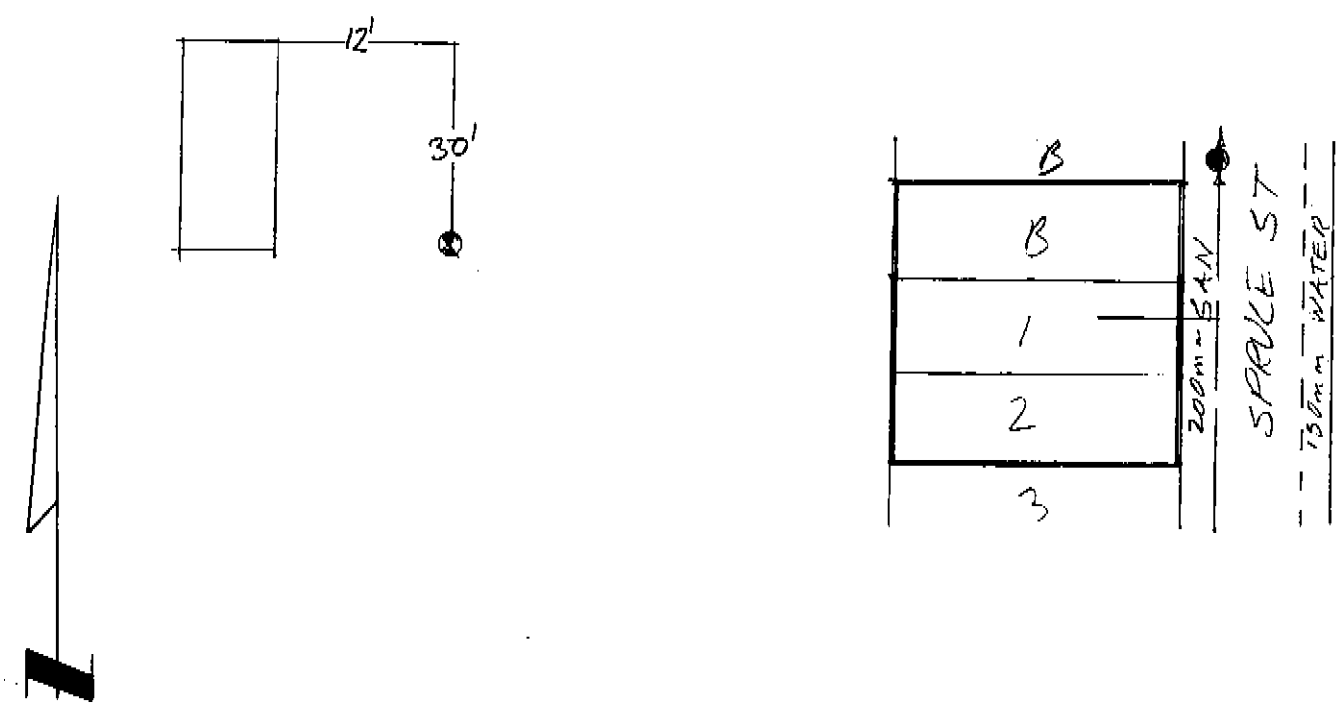
SITE PLAN N.T.S.