City of Prince George
HISTORY SHEET

SHEET NUMBER **PID #** 010213031

Legal: LOT'S 18 BLOCK D.L. 2608 PLAN 20043

Address: 4405 FIRST AVE.

Sanitary Connection: # 7562 SIZE 100 mm MATERIAL A.C. INV. CONNECTED

Water Connection: # 7582 SIZE 20 mm MATERIAL CU. METER CONNECTED

Storm Connection: # SIZE mm MATERIAL INV. CONNECTED

Cash Receipt No's: WATER SANITARY STORM

CURB FROM PROPERTY LINE 5.791 m PAVEMENT WIDTH 12.801 m

B.C. HYDRO U/G UNDERGROUND CONNECTION

B.C. TELEPHONE U/G UNDERGROUND CONNECTION

INLAND GAS 3.048 m FROM PL.

Information Sheets:

Comments: WITH THAW WIRE.

THE INFORMATION CONTAINED HEREIN IS FOR INTERNAL USE ONLY.
NOT TO BE RELIED UPON UNLESS CONFIRMED BY SITE INSPECTION AND/OR INVESTIGATION

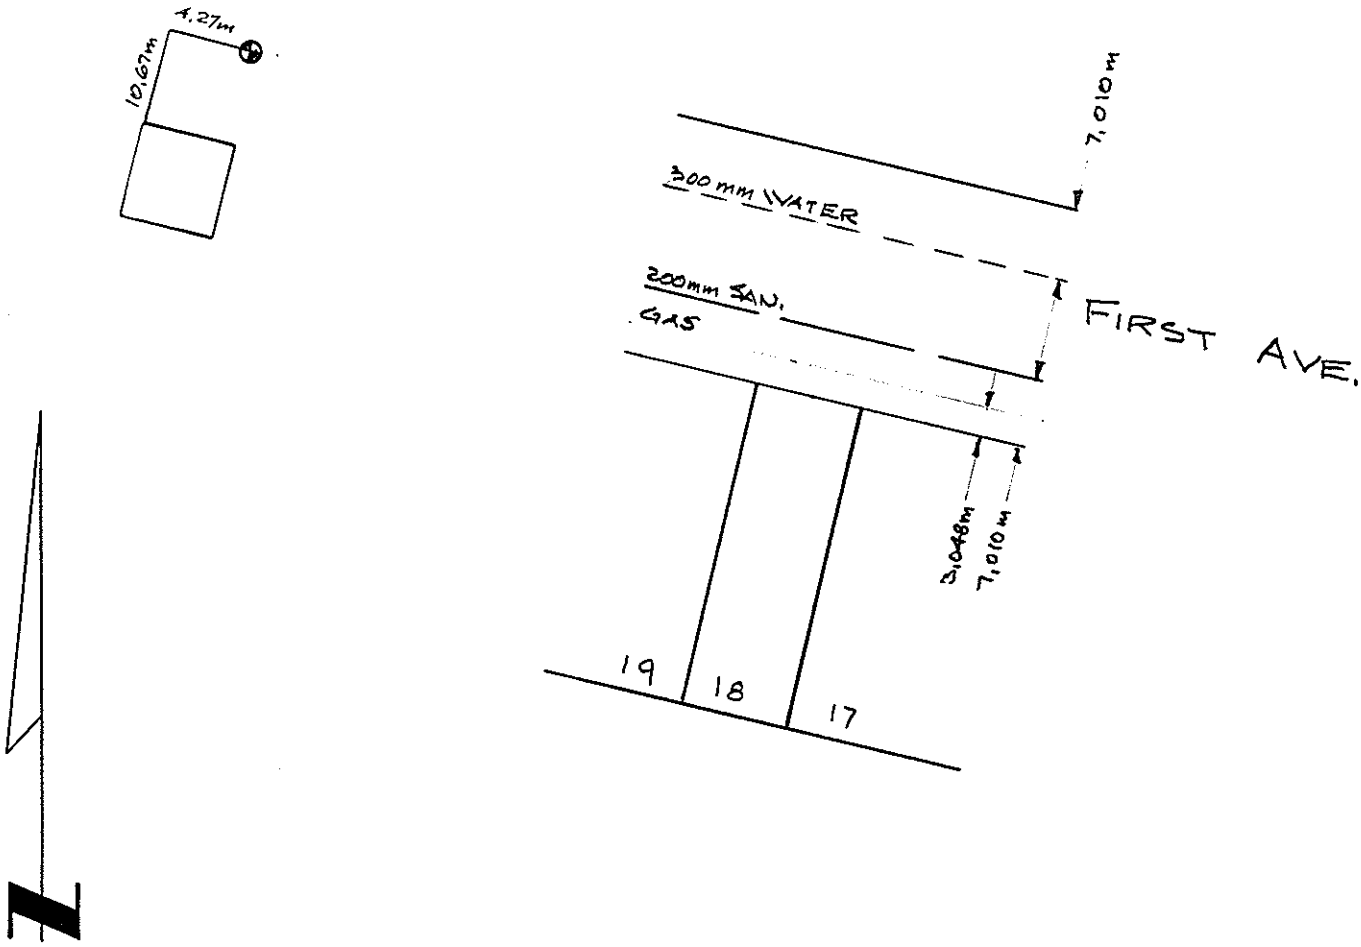

CITY PUBLIC WORKS DEPT. 01021303 1

REPORT TO RECORDS

WATER SERVICE INFORMATION

JUN 12 1987

Lot No. 18 Block — D.L. 2608

Address 4405 1ST AVENUE

Size of Connection ☐ ½" ☐ ¾" ☐ Other _____

Type of Connection ☐ Copper ☐ Iron

Thaw Wire ☐ Yes ☐ No

PL 20043

LOCATION SKETCH

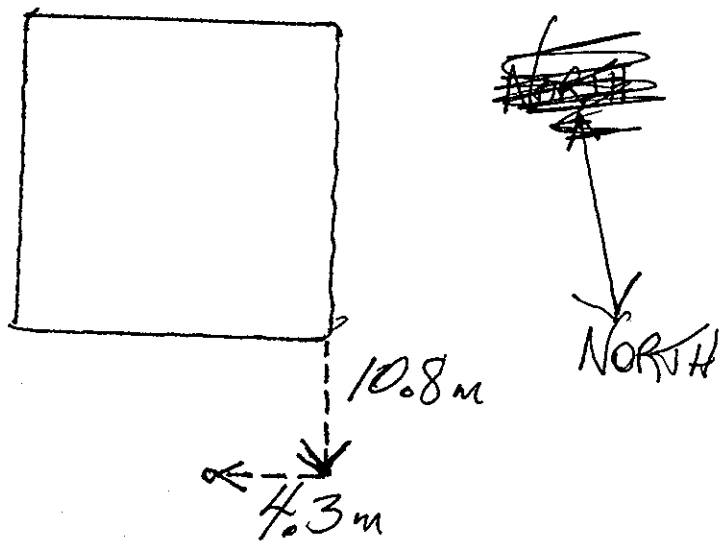

Field Location By W Bond Date June 9/87

Checked by: _____

Form PW-38