City of Prince George
HISTORY SHEET

SHEET NUMBER 10929 **Roll Number** 010217 221

Legal: LOT'S 11 BLOCK D.L. 4377 PLAN 20086

Address: 2125 AINTREE DR.

Sanitary Connection: # 12014 SIZE 4" Ø MATERIAL INV. 2130.65 CONNECTED

Water Connection # SIZE 20mm MATERIAL Cu METER CONNECTED

Storm Connection: # SIZE MATERIAL INV. CONNECTED

Cash Receipt No's: WATER SANITARY 1240 STORM

CURB FROM PROPERTY LINE PAVEMENT WIDTH

B.C. HYDRO UNDERGROUND CONNECTION

B.C. TELEPHONE UNDERGROUND CONNECTION

INLAND GAS

Information Sheets:

Comments:
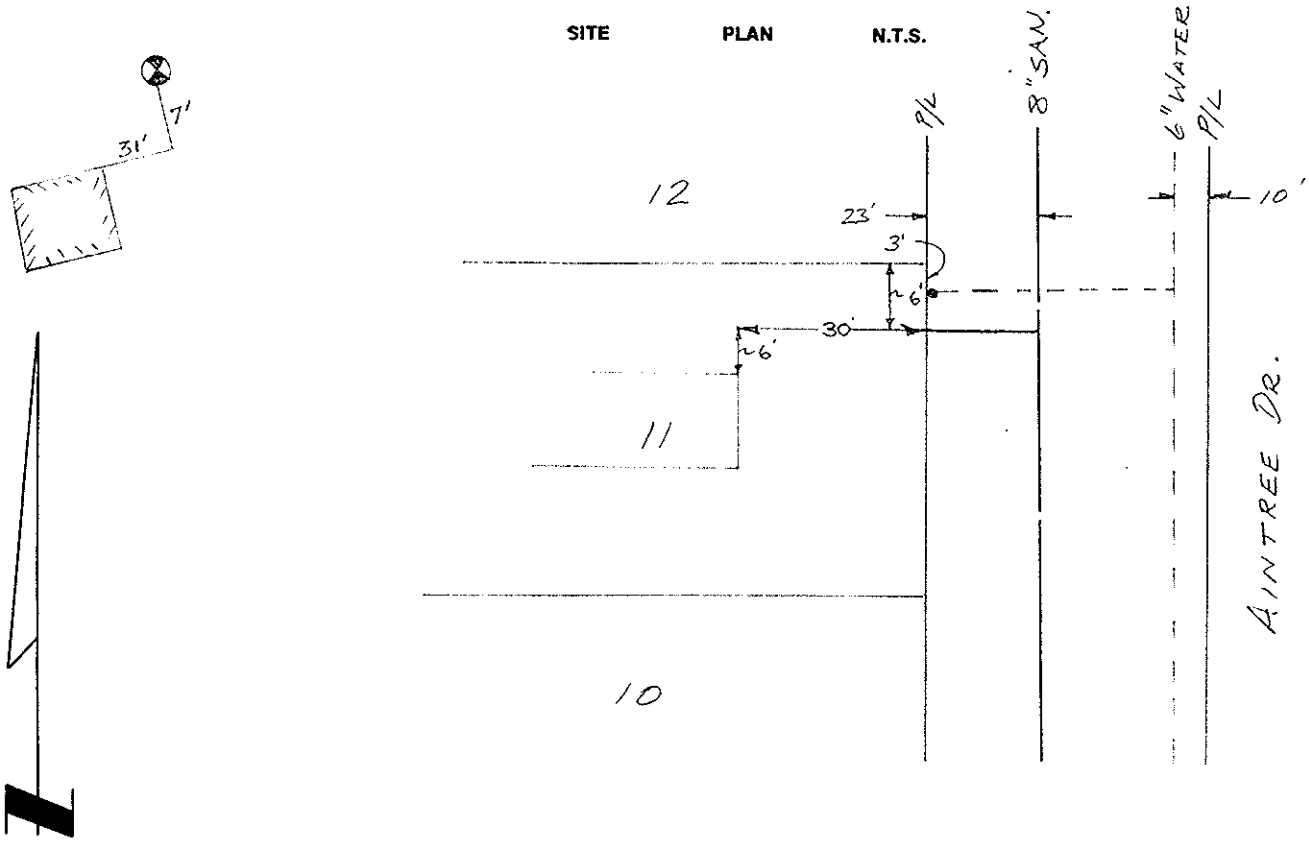
SITE PLAN N.T.S.